


NOTED BY:	
RMS	<i>[Signature]</i>
GSA	<i>[Signature]</i>
EGC	<i>[Signature]</i>

FOR SALES AVAILABILITY ONLY

NO.	DATE	REVISIONS

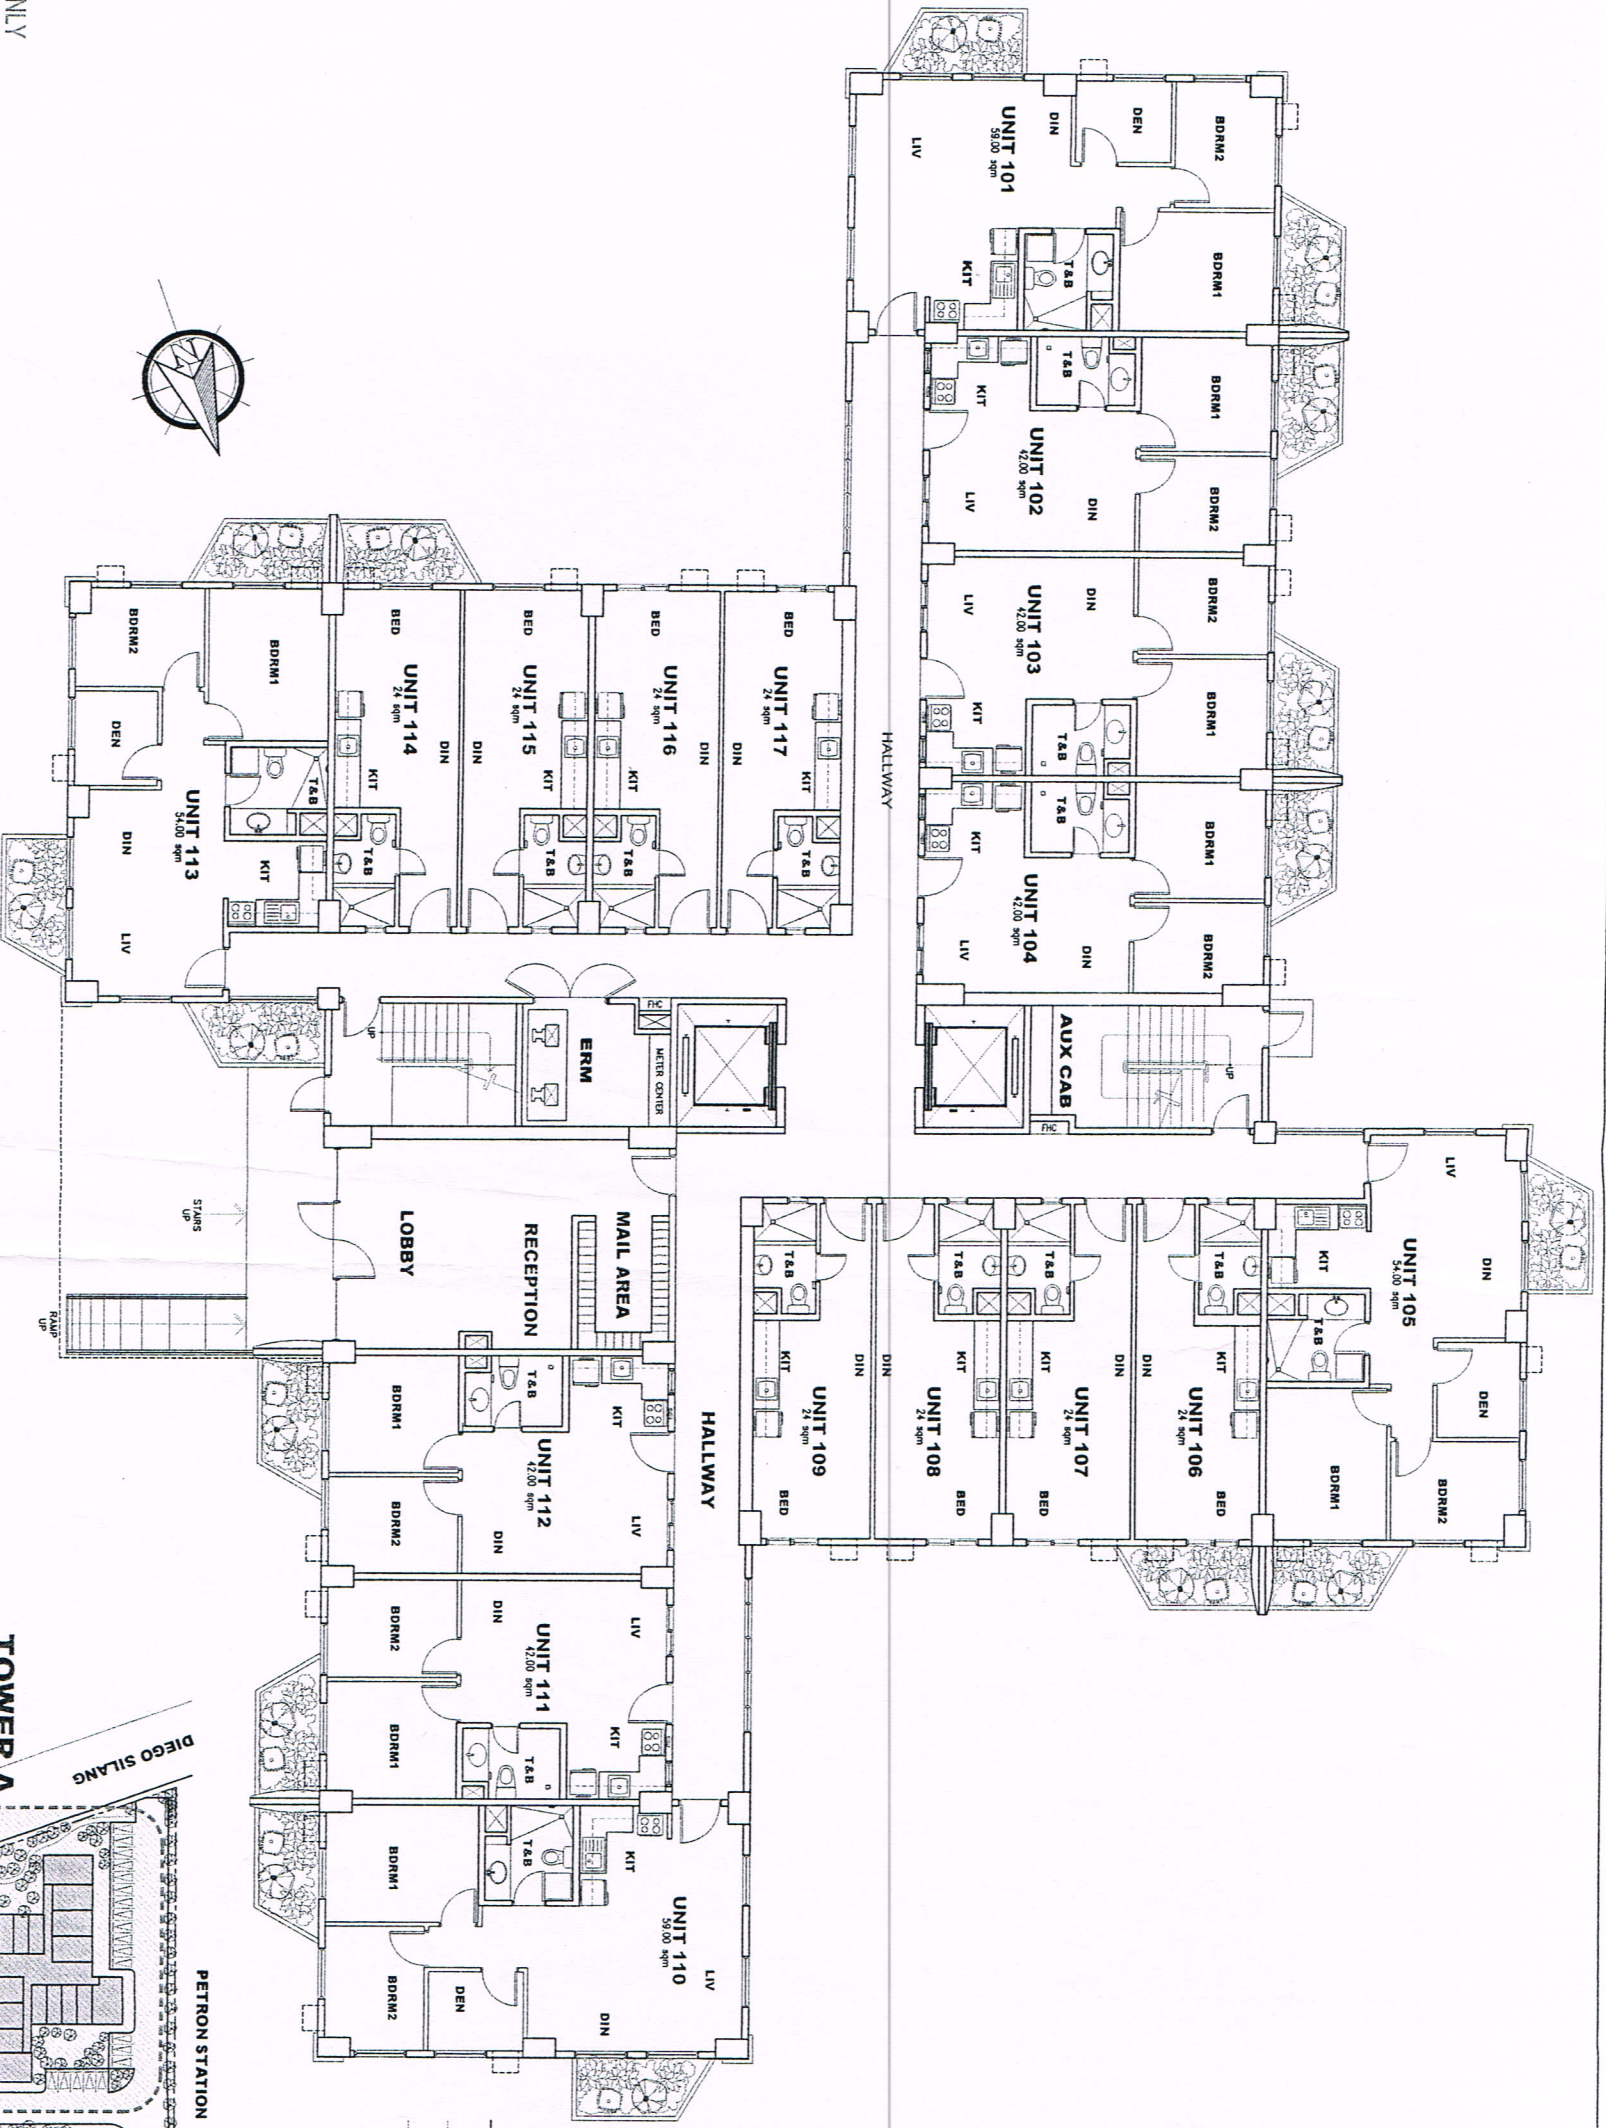

CYPRESS TOWERS




"TOWER A" (ALTIVA)



GROUND FLOOR PLAN

31 JULY 2008

AVAILABILITY PLANS

KEY PLAN

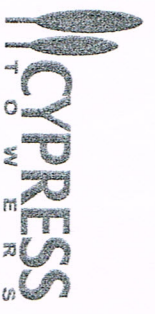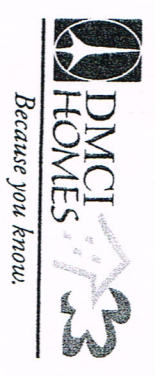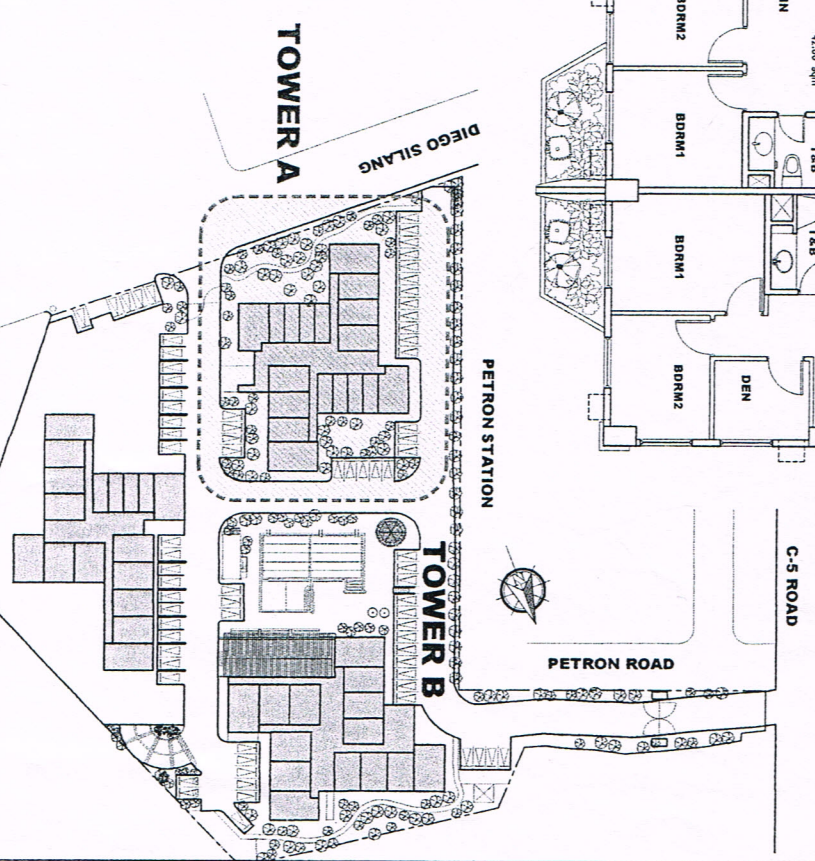

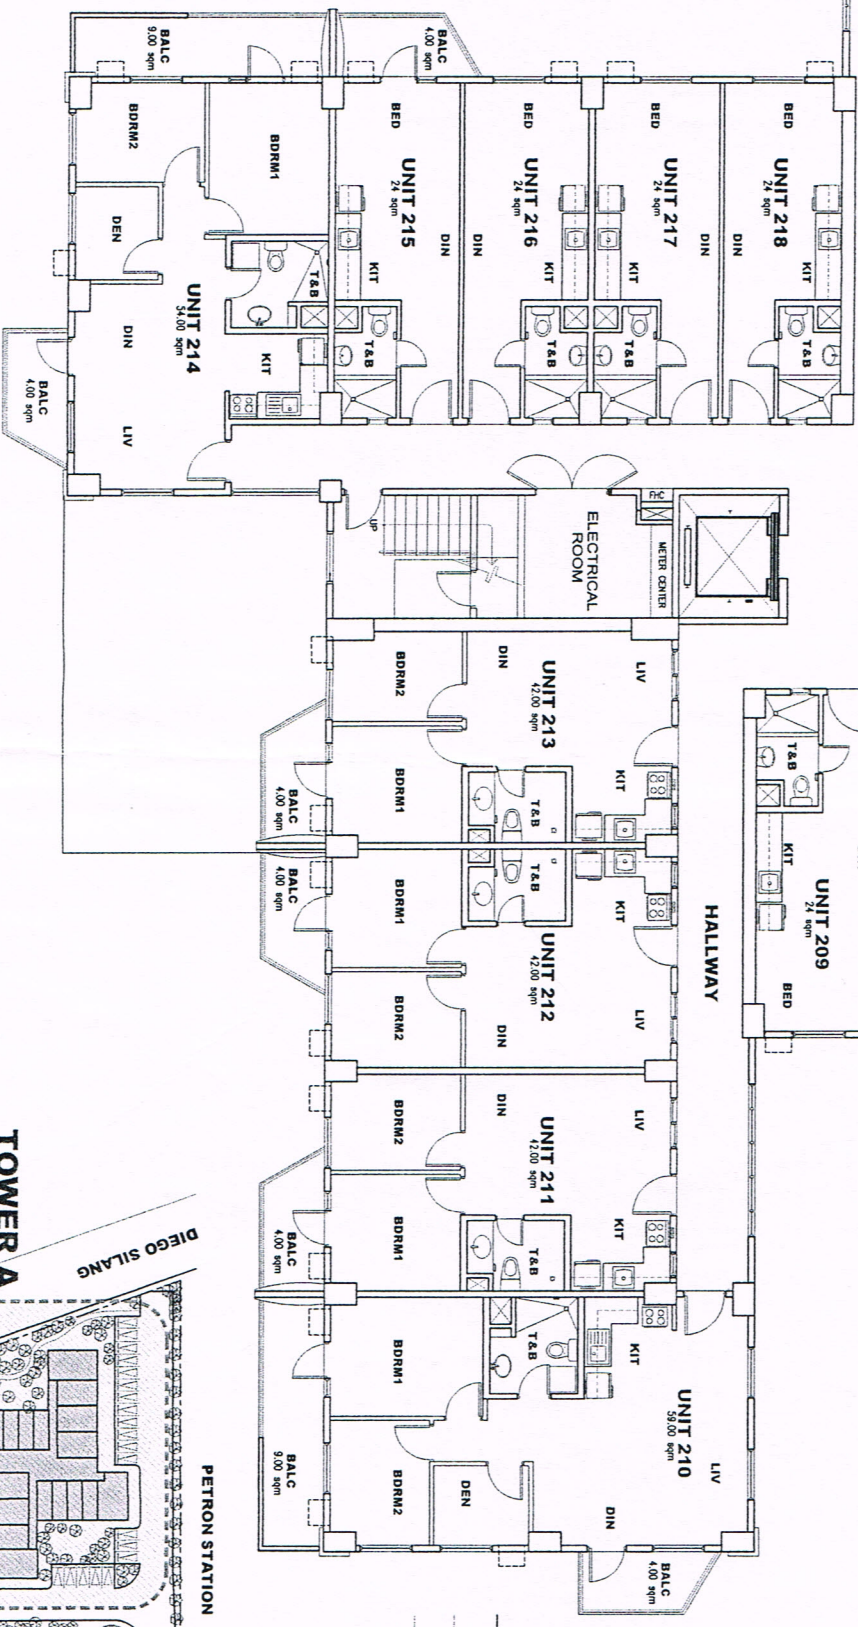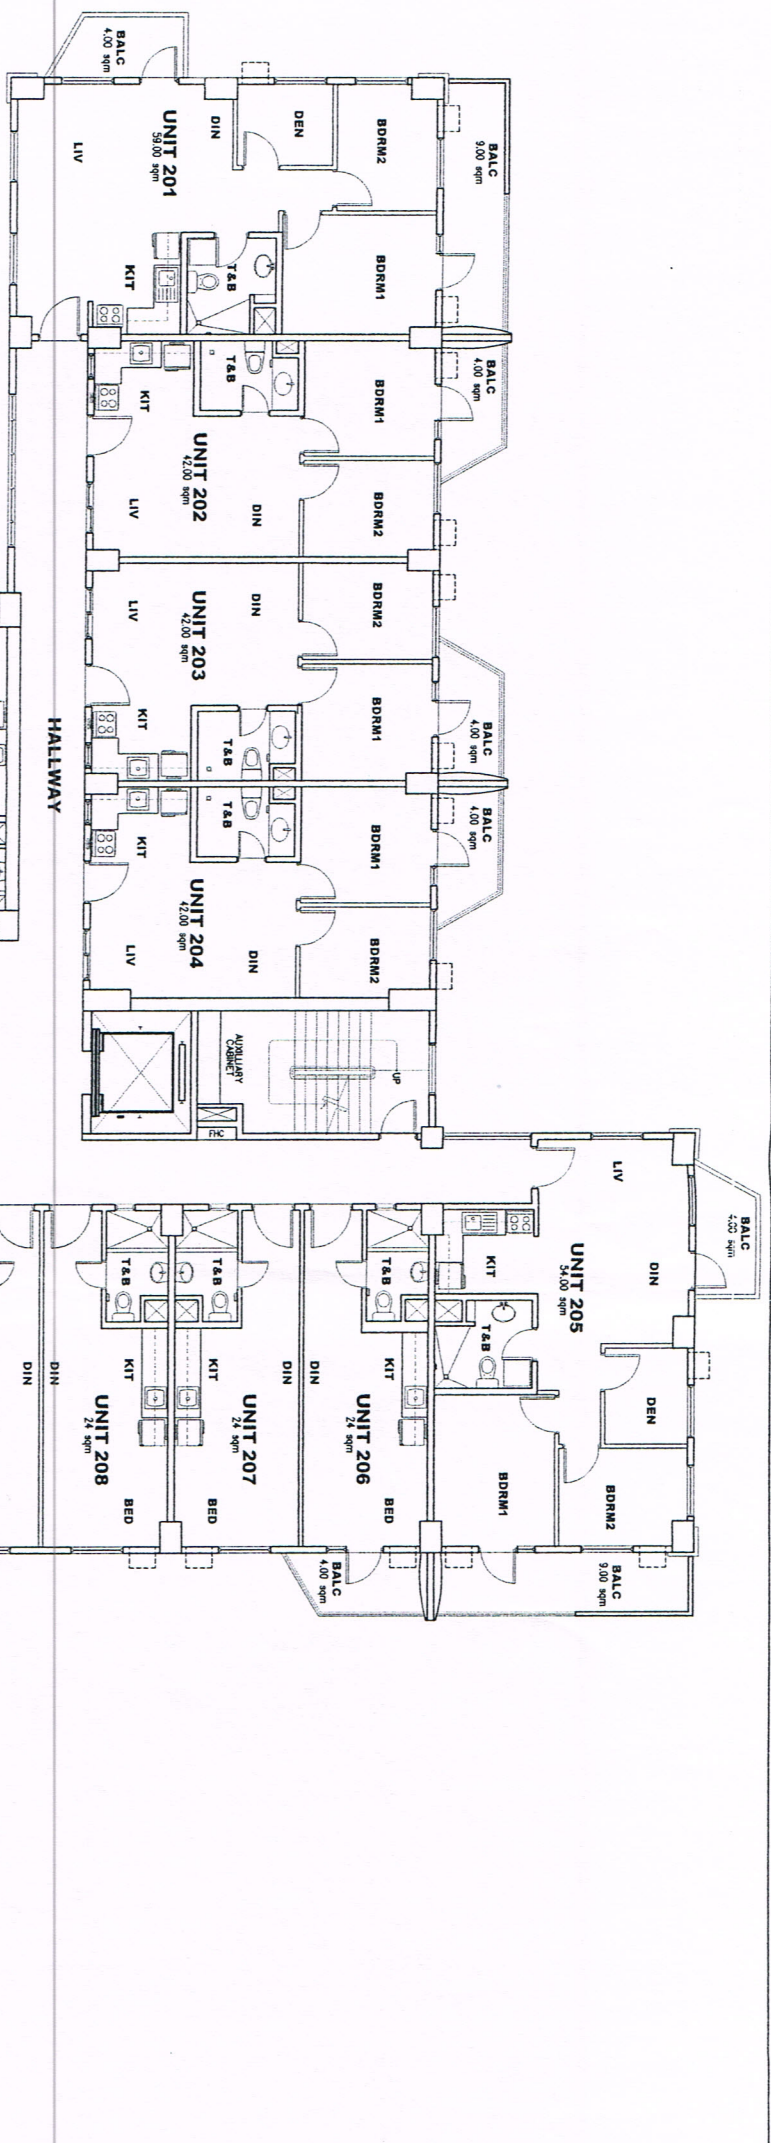

NOTED BY:

RMS	<i>[Signature]</i>
GSA	<i>[Signature]</i>
EGC	<i>[Signature]</i>

FOR SALES AVAILABILITY ONLY

NO	DATE	REVISIONS




CYPRESS TOWERS

"TOWER A" (ALTIVA)

2ND FLOOR PLAN
31 JULY 2008
AVAILABILITY PLANS



KEY PLAN

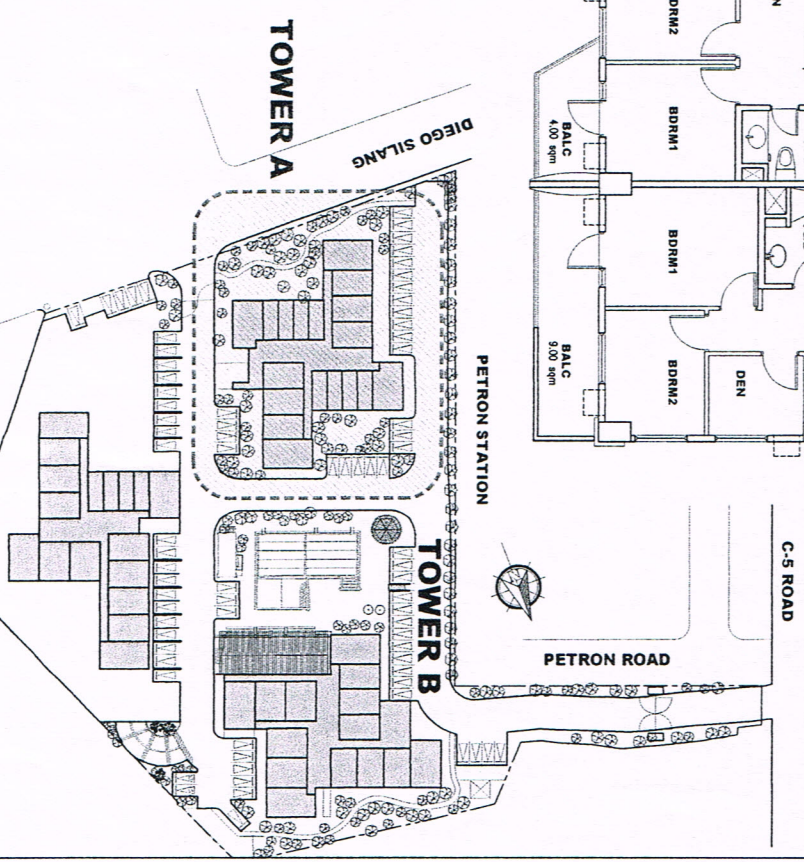

NOTED BY:		
RMS	<i>Shawn</i>	3/11/08
GSA	<i>3/11/08</i>	
EGC	<i>3/11/08</i>	

FOR SALES AVAILABILITY ONLY

NO.	DATE	REVISIONS

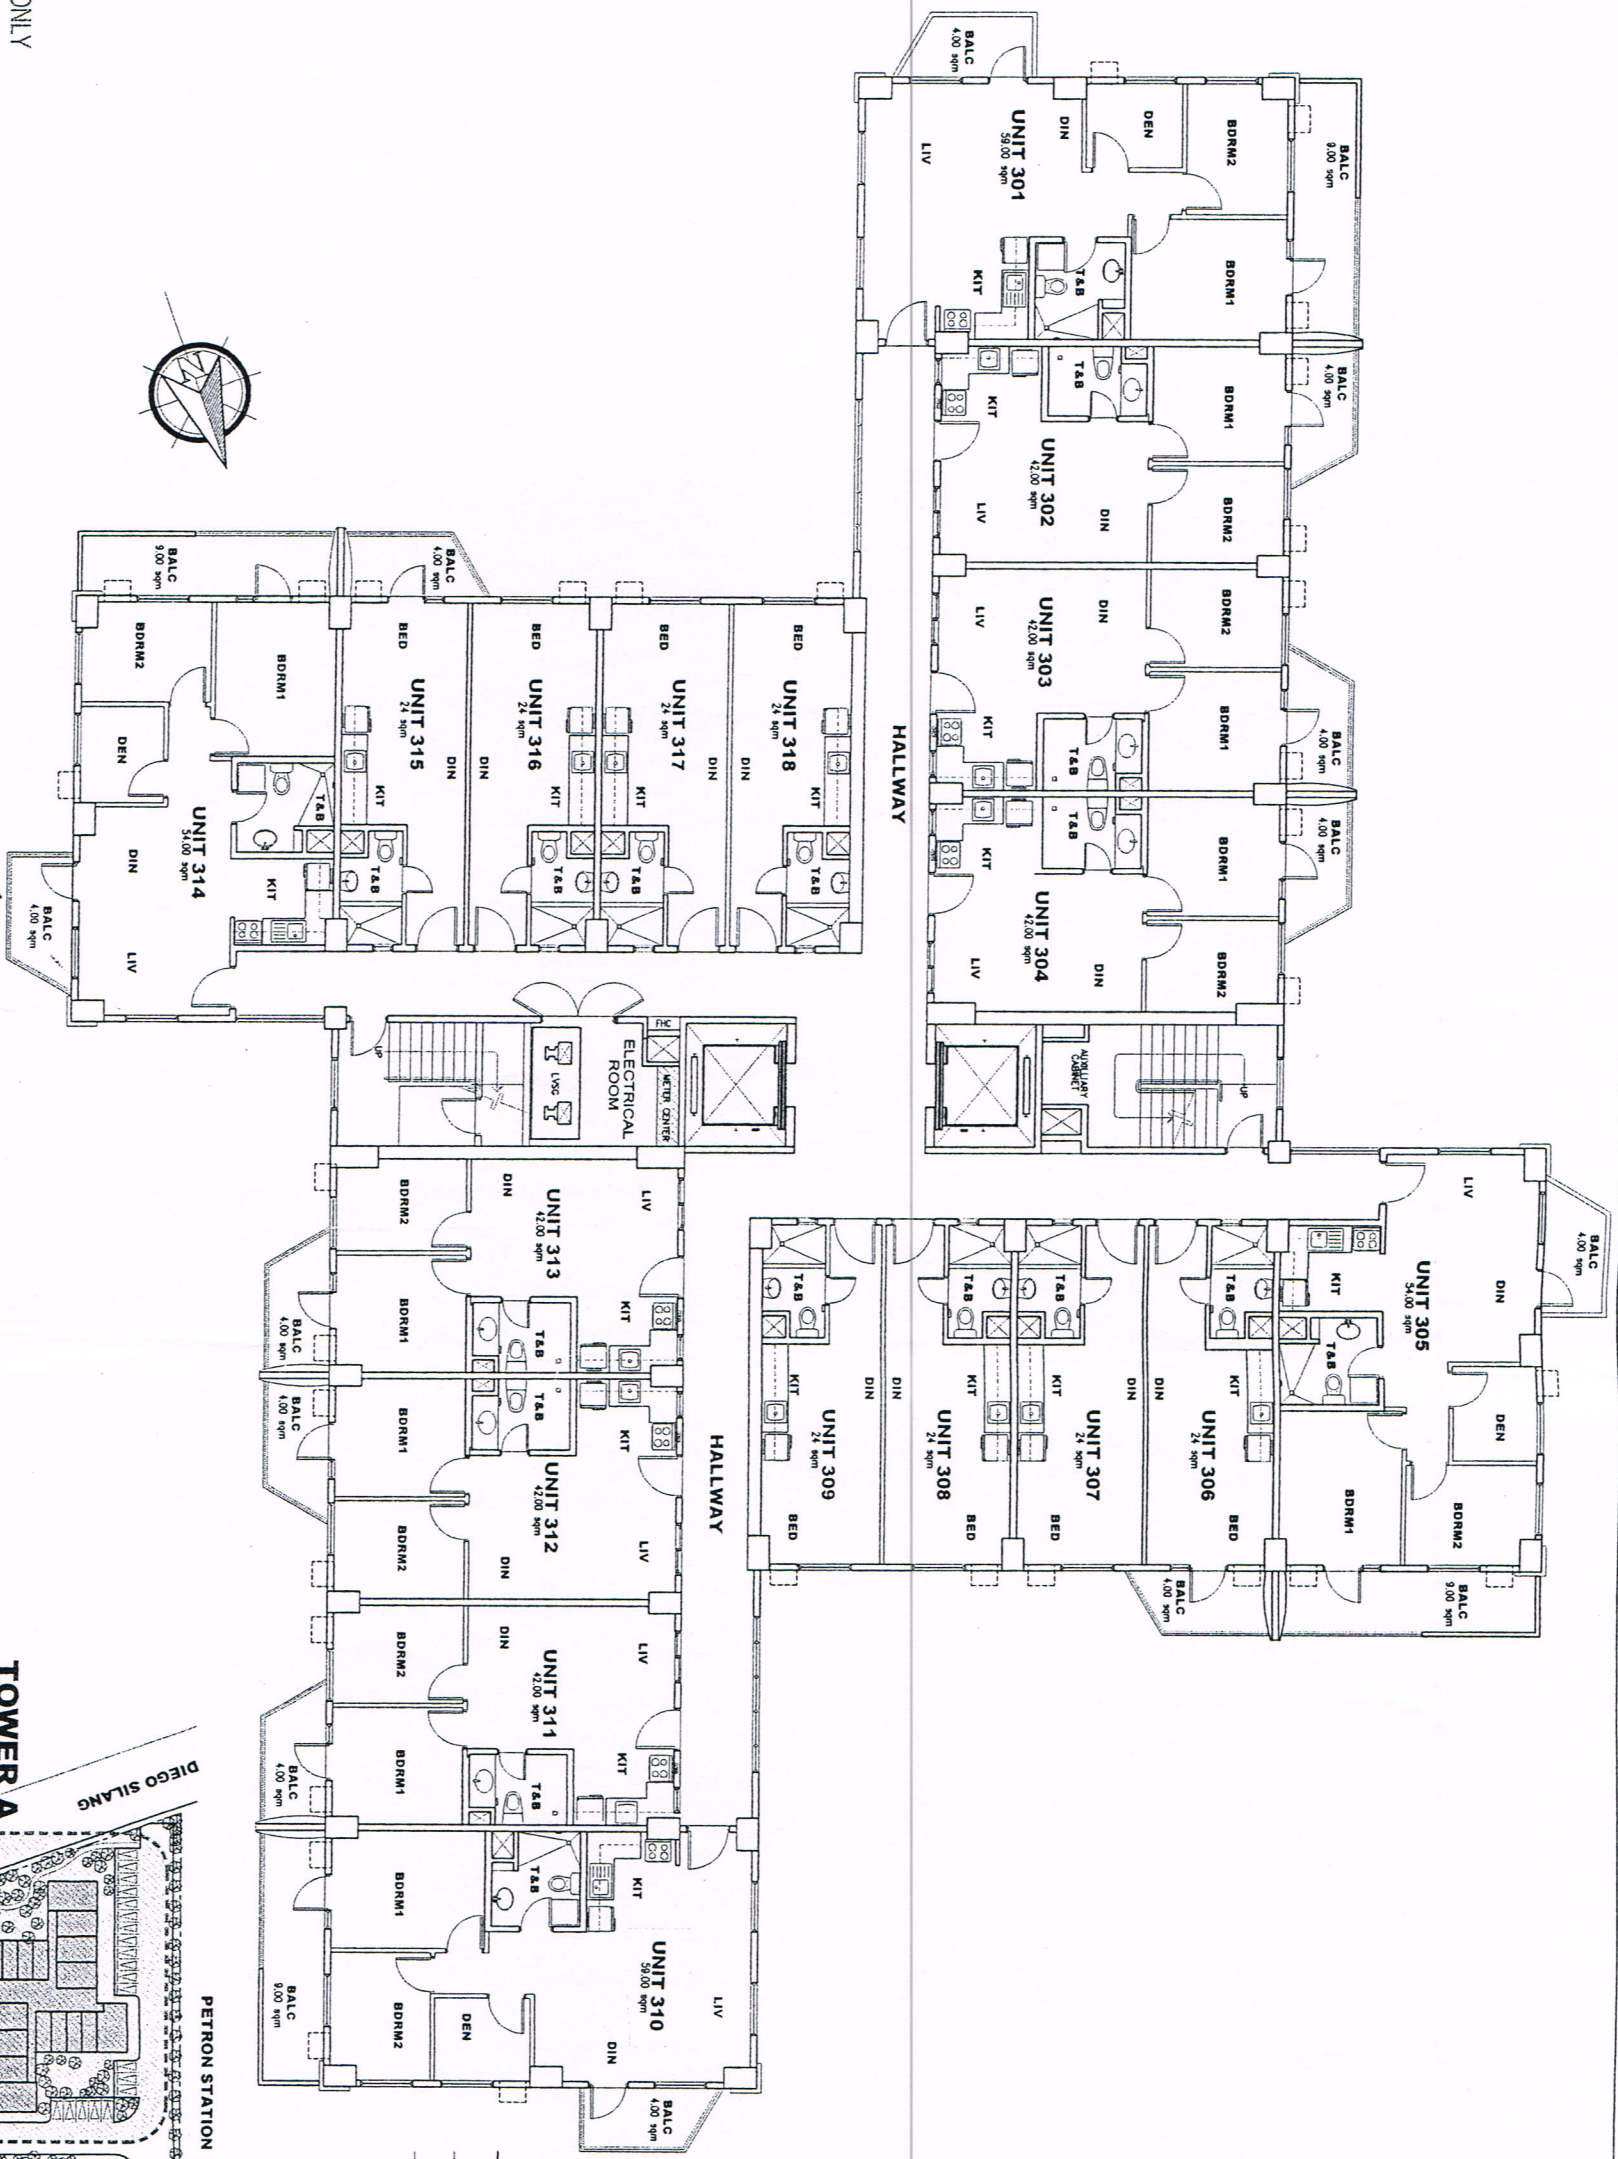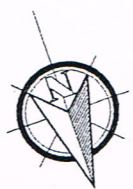

CYPRESS TOWERS



"TOWER A" (ALTIVA)



3RD FLOOR PLAN

31 JULY 2008

AVAILABILITY PLANS

KEY PLAN

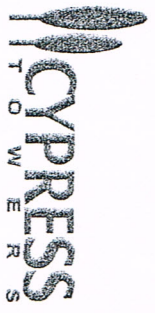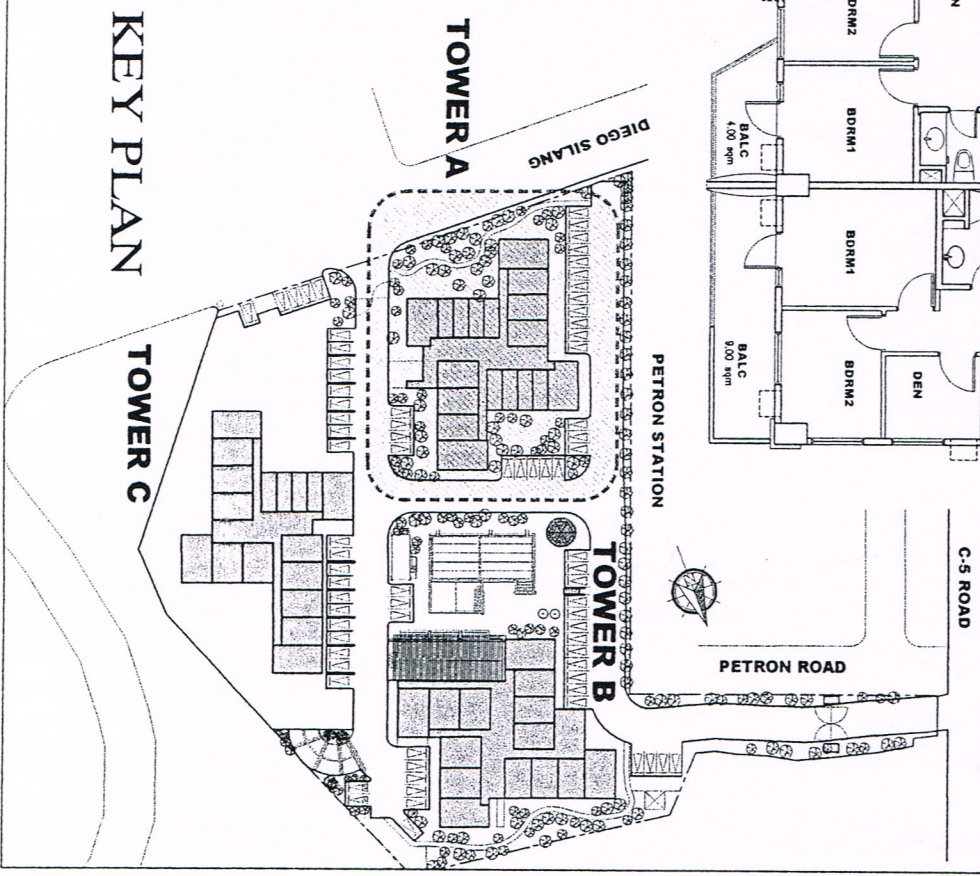

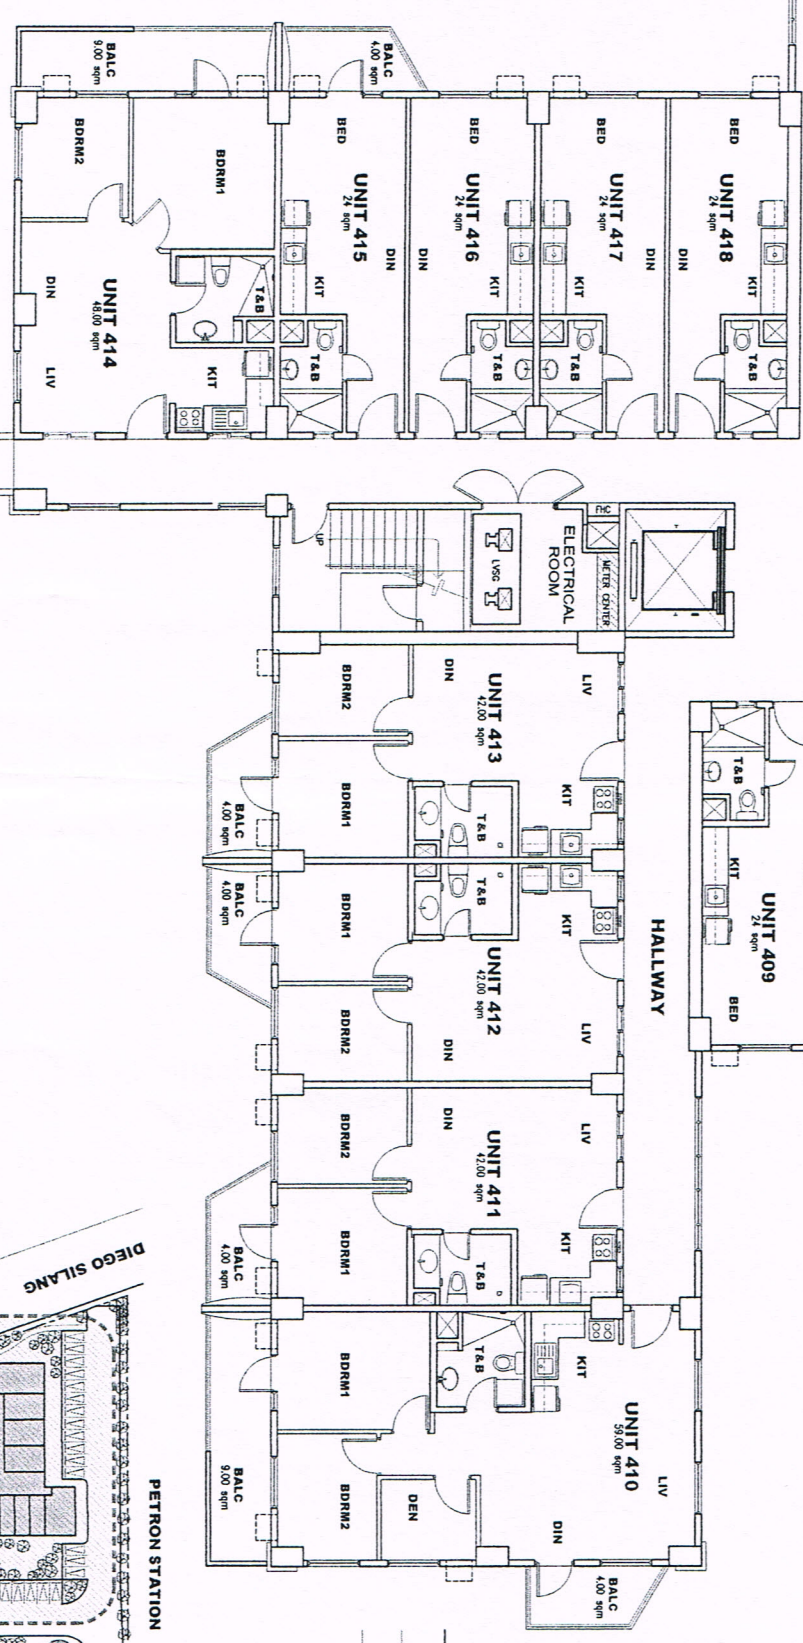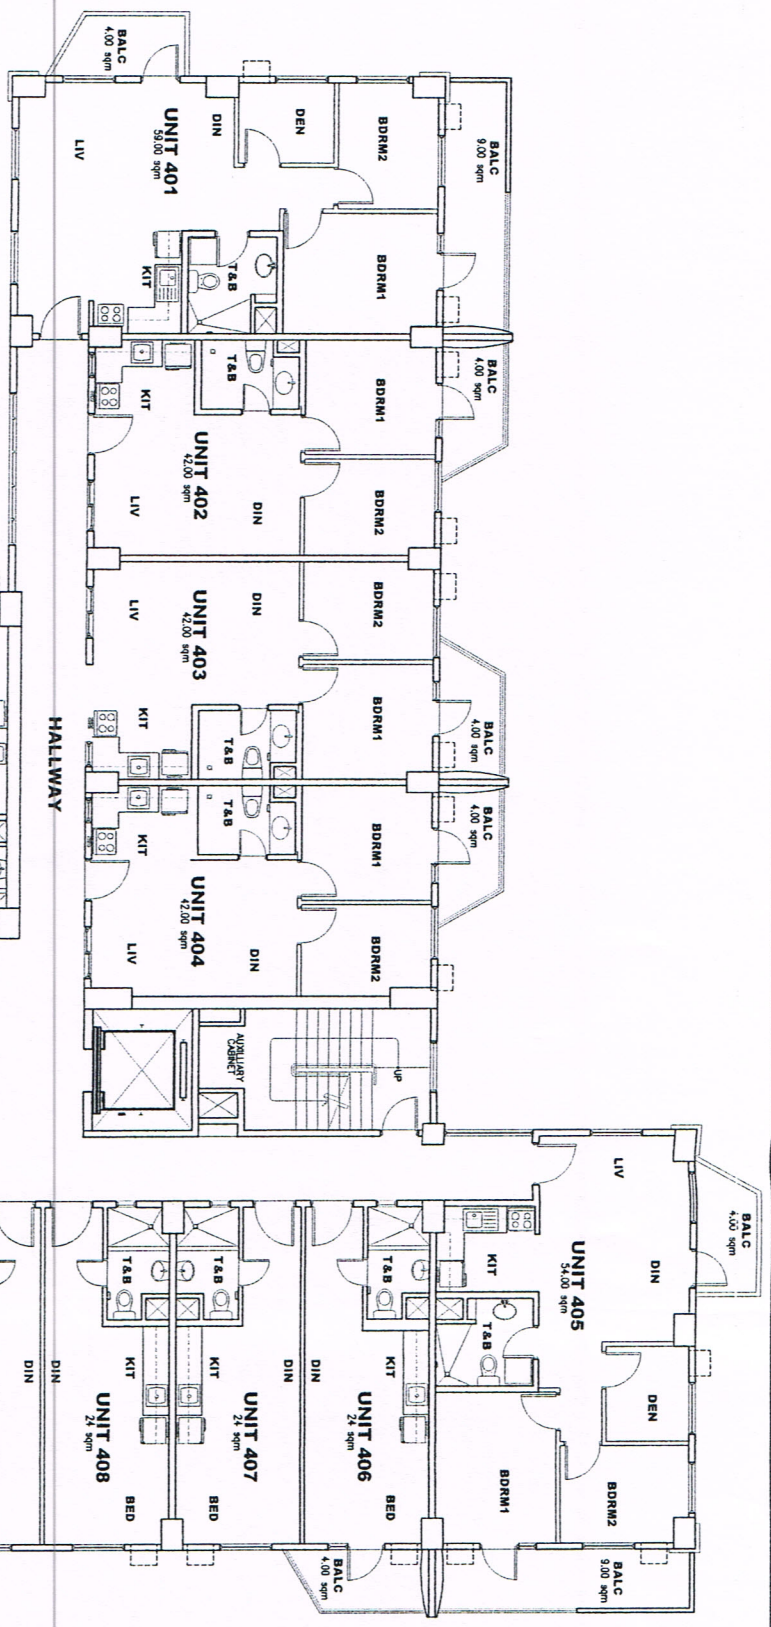

NOTED BY:

RMS	<i>[Signature]</i>	3/1/08
GSA	<i>[Signature]</i>	3/1/08
EGC	<i>[Signature]</i>	<i>[Signature]</i>

FOR SALES AVAILABILITY ONLY

NO.	DATE	REVISIONS





LINK BRIDGE
(TO TOWER CELESTA)



CYPRESS TOWERS

"TOWER A" (ALTIVA)

4TH FLOOR PLAN
31 JULY 2008
AVAILABILITY PLANS

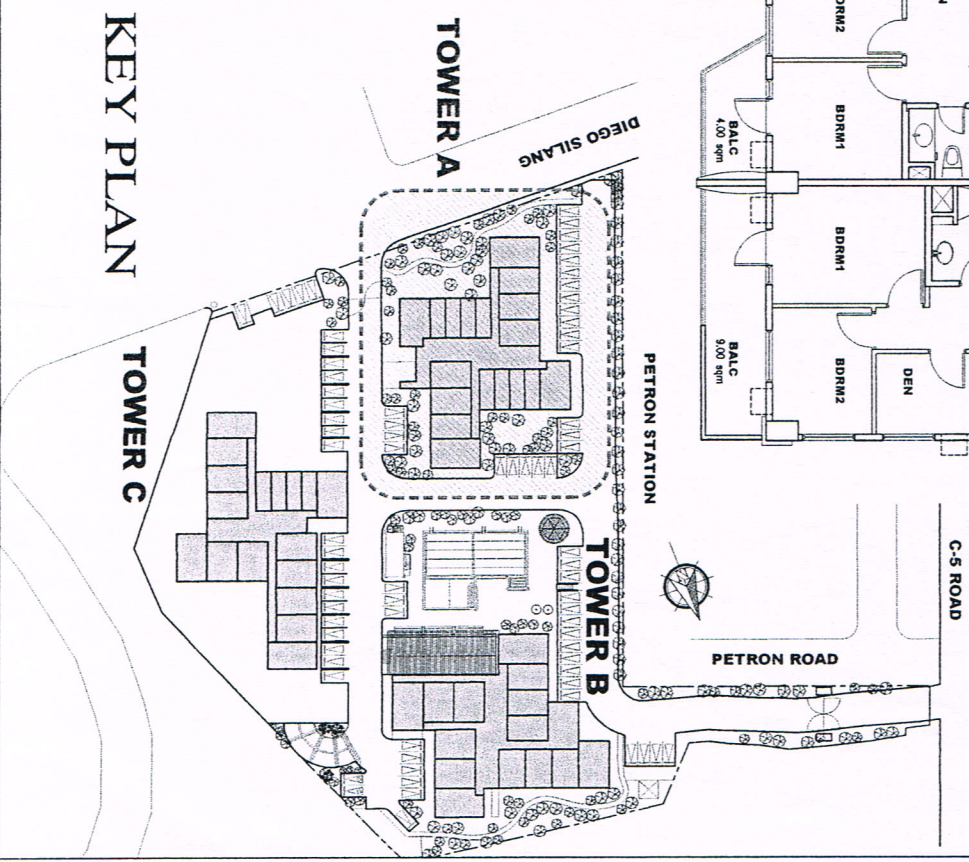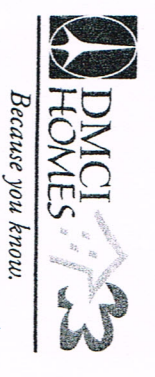

KEY PLAN

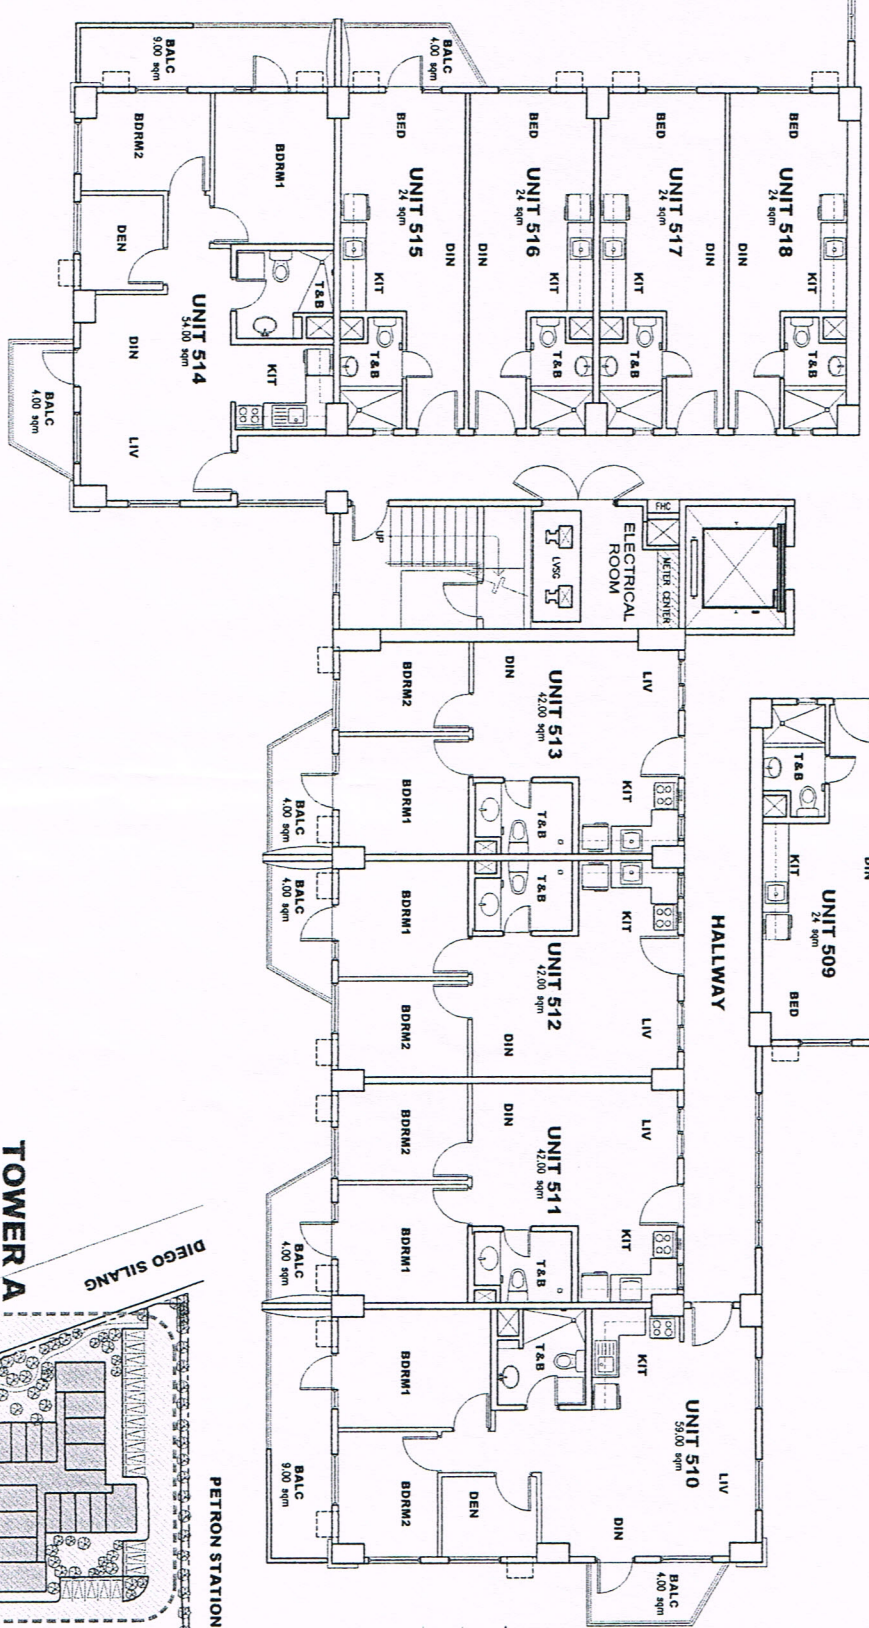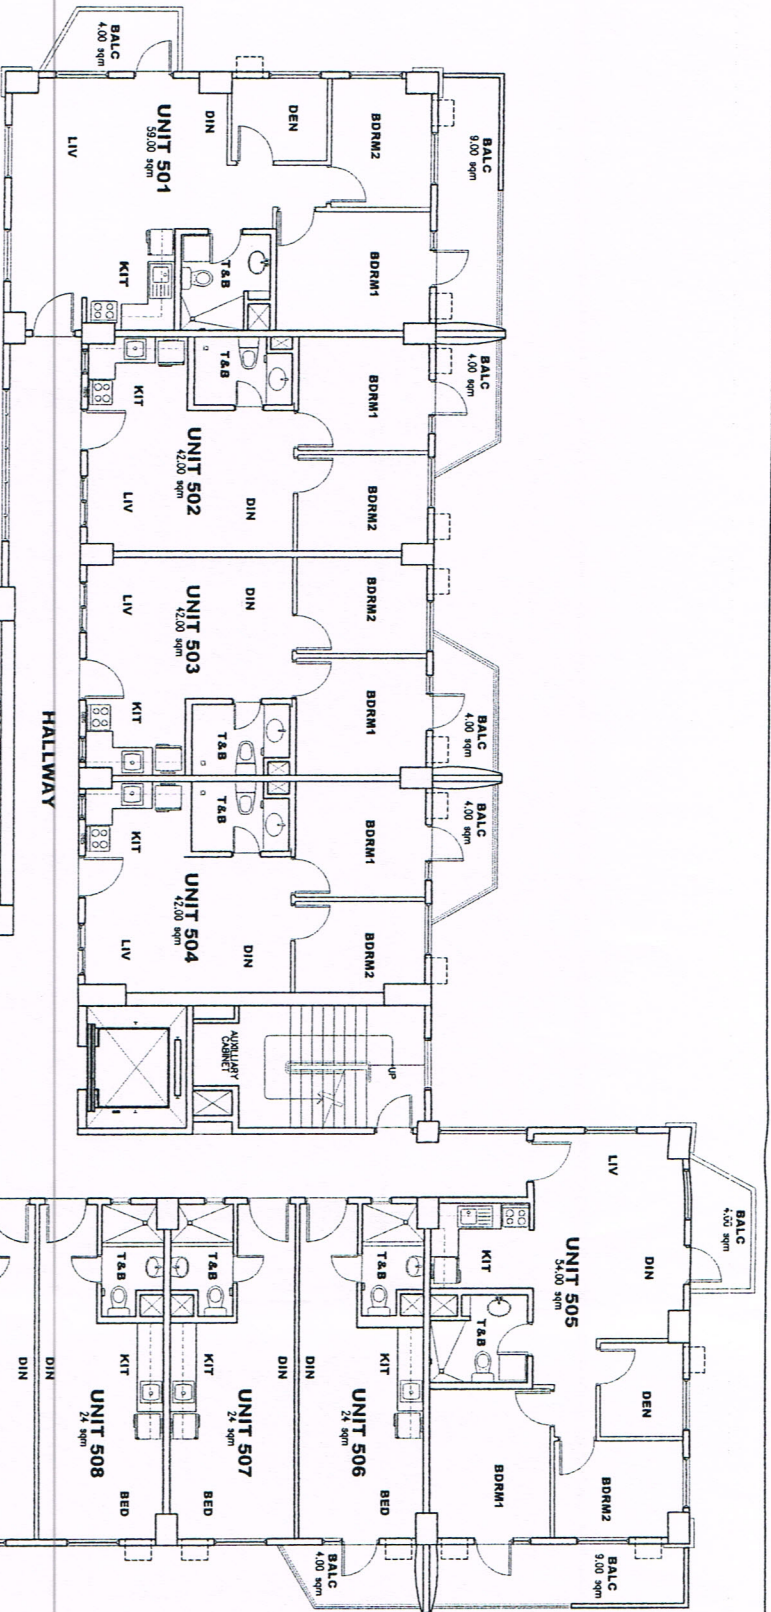


NOTED BY:

RMS	3/1/08
GSA	3/1/08
EGC	3/1/08

FOR SALES AVAILABILITY ONLY

NO. DATE REVISIONS



--	--	--

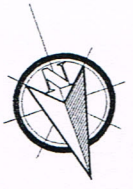

CYPRESS TOWERS

"TOWER A" (ALTIVA)

TYP. 5TH TO 16TH FLOOR PLAN
31 JULY 2008
AVAILABILITY PLANS

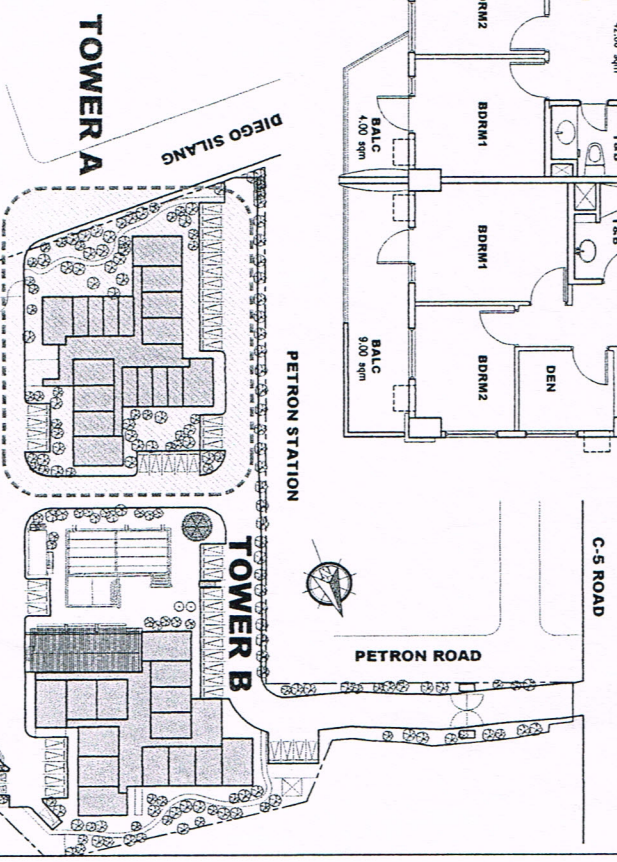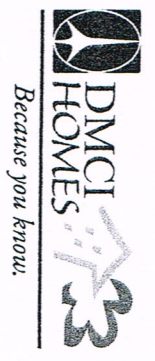

KEY PLAN

TOWER A



TOWER B

TOWER C

NOTED BY:	
RMS	<i>[Signature]</i>
GSA	<i>[Signature]</i>
EGC	<i>[Signature]</i>

FOR SALES AVAILABILITY ONLY

NO.	DATE	REVISIONS

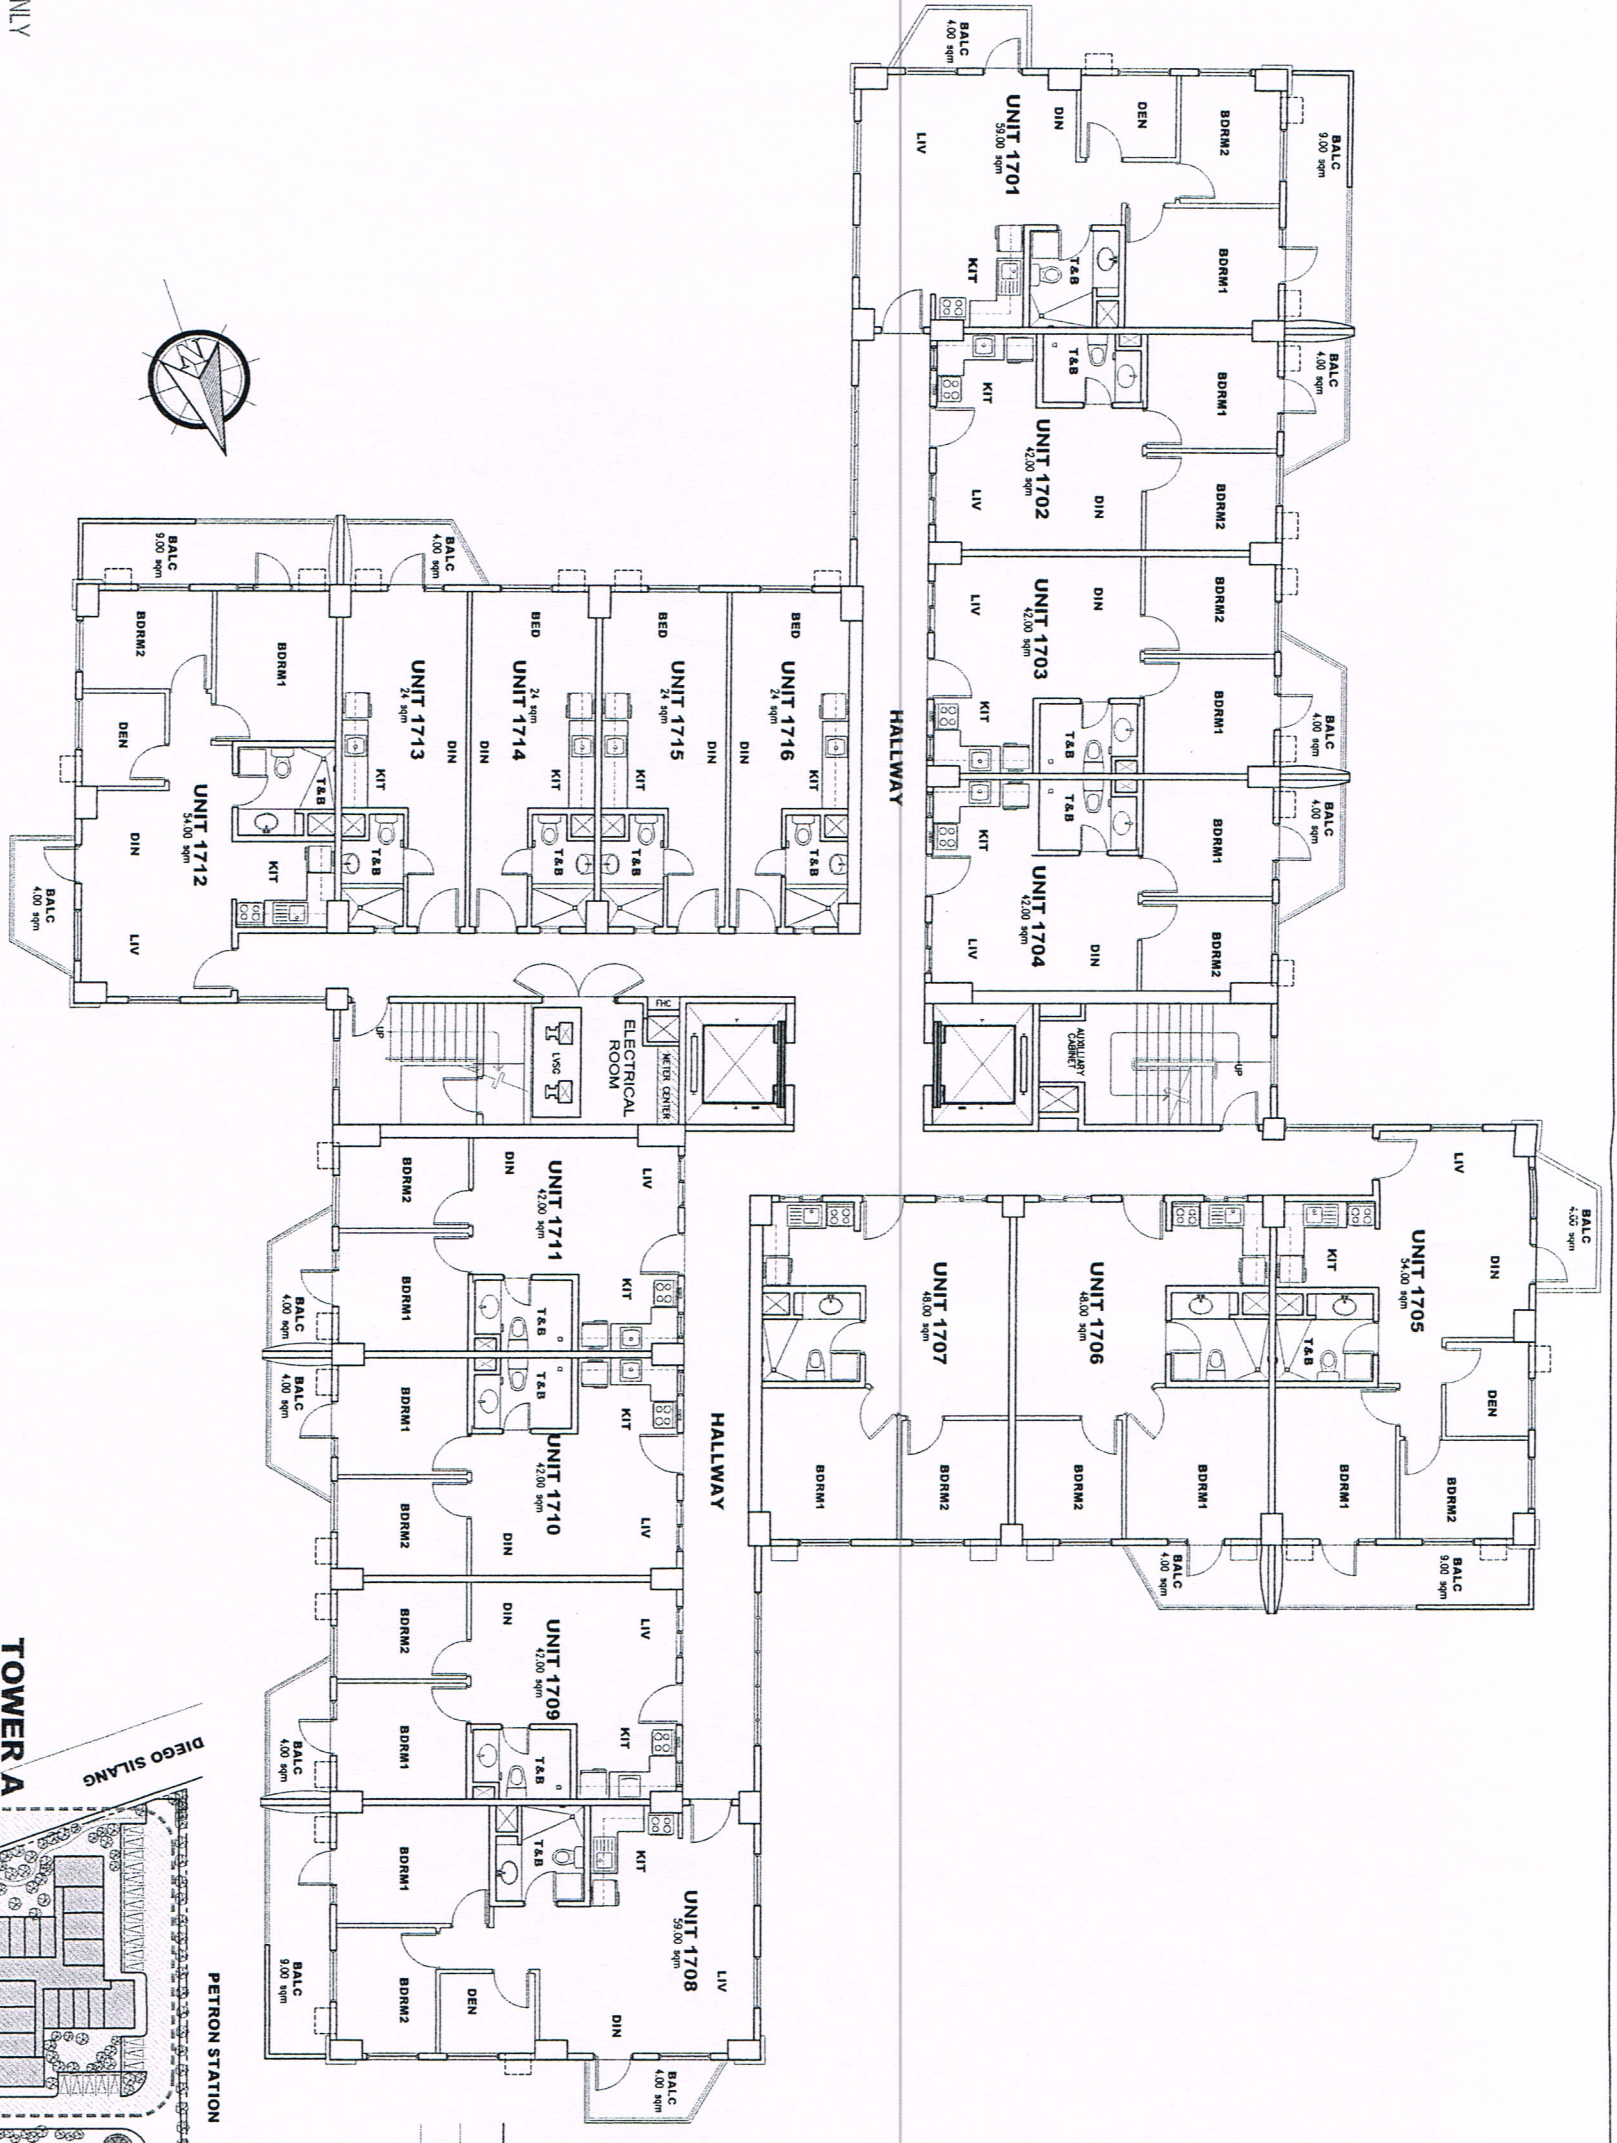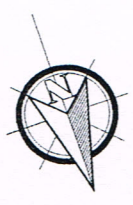


CYPRESS TOWERS



"TOWER A" (ALTIVA)

TYP. 17TH TO 22ND FLOOR PLAN

31 JULY 2008
AVAILABILITY PLANS

KEY PLAN

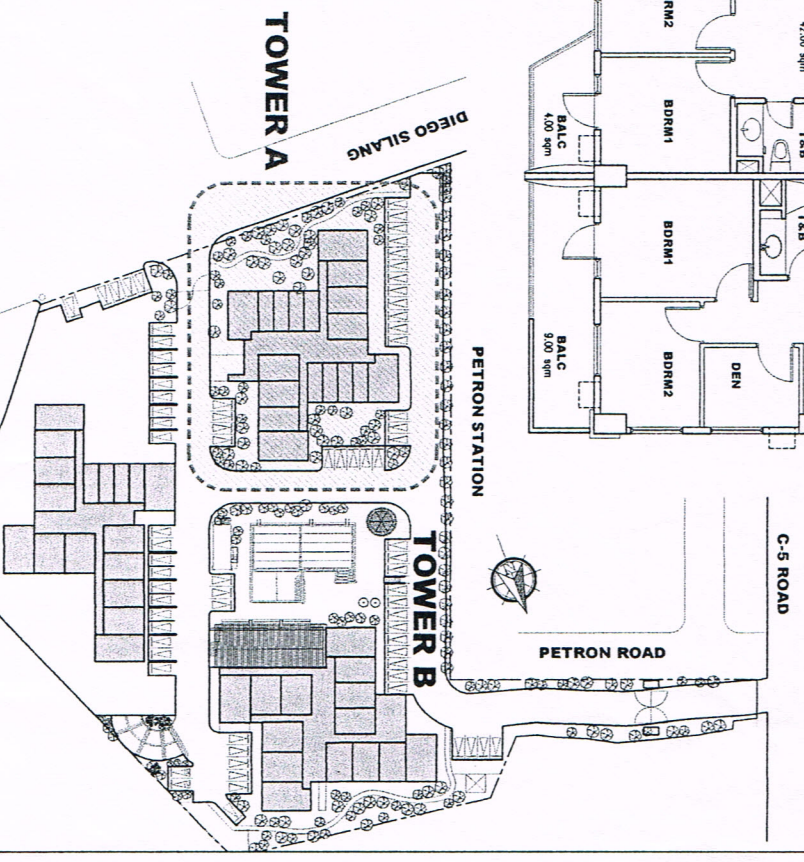

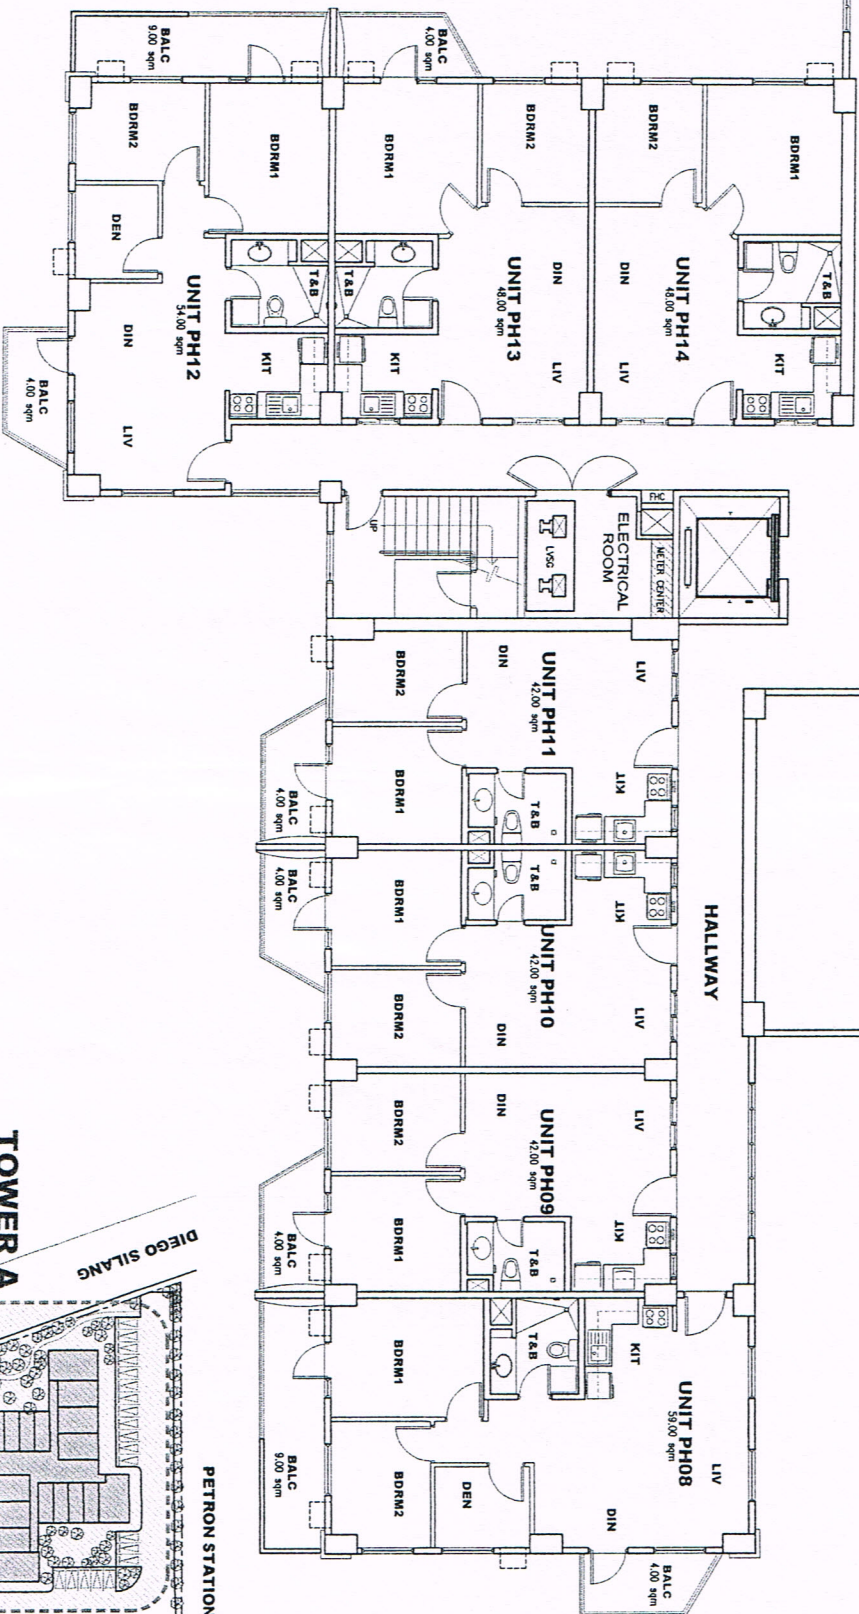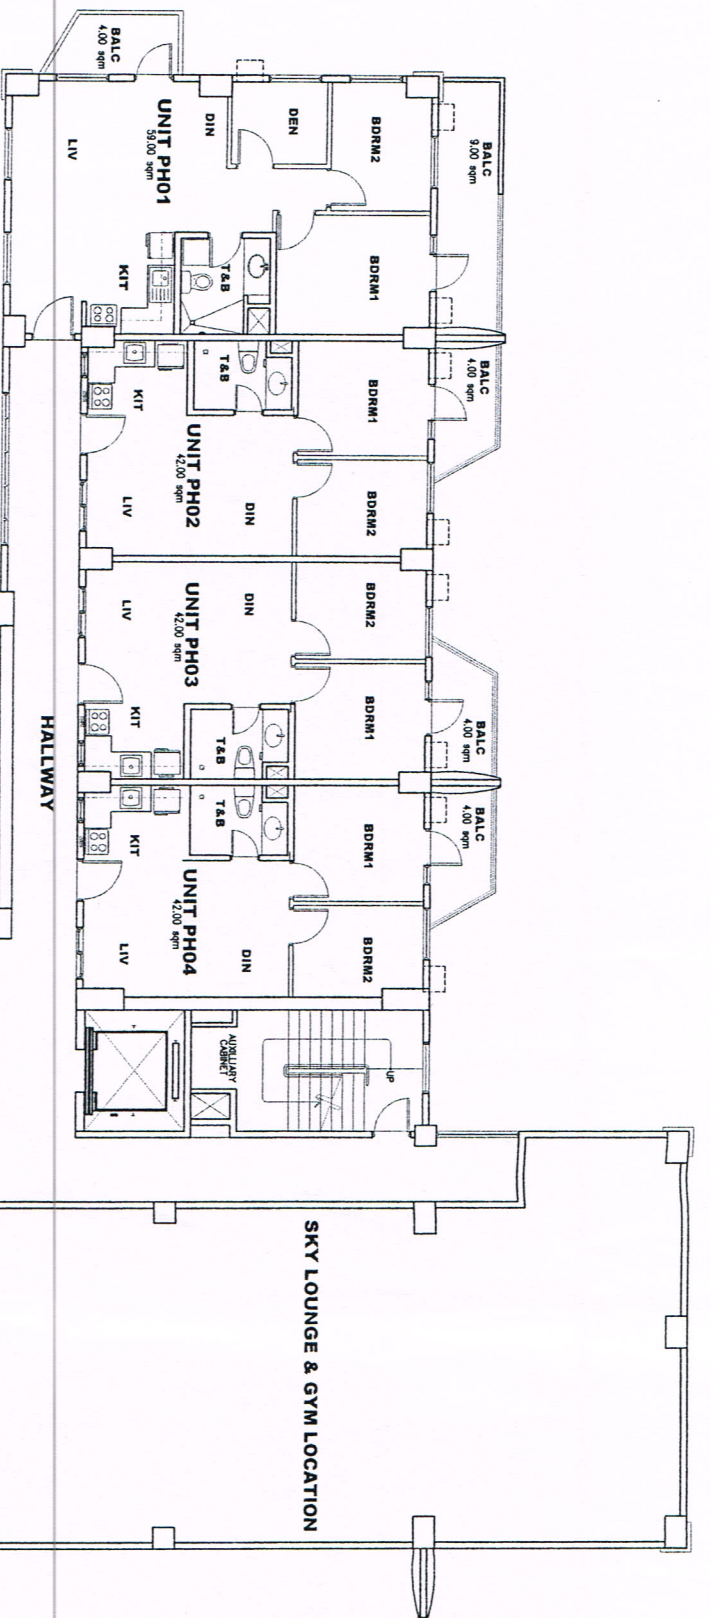


NOTED BY:

RMS	<i>[Signature]</i>	13/11/11
GSA	<i>[Signature]</i>	3/11/11
EGC	<i>[Signature]</i>	<i>[Signature]</i>

FOR SALES AVAILABILITY ONLY

NO. DATE REVISIONS

--	--	--

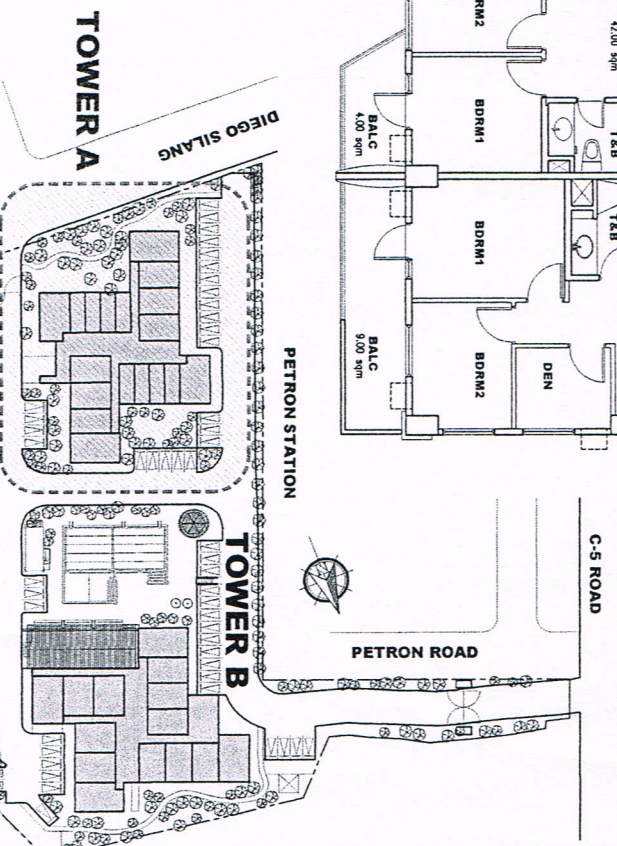


CYPRESS TOWERS

"TOWER A" (ALTIVA)

PENTHOUSE (23RD) FLOOR PLAN

31 JULY 2008
AVAILABILITY PLANS


KEY PLAN

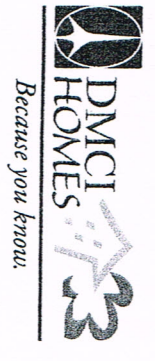



D.M. CONSUNJI, INC.
ENGINEERS • CONTRACTORS

2281 PASONG TAMO EXTENSION, MAKATI CITY
TEL. NO.: 841-0841

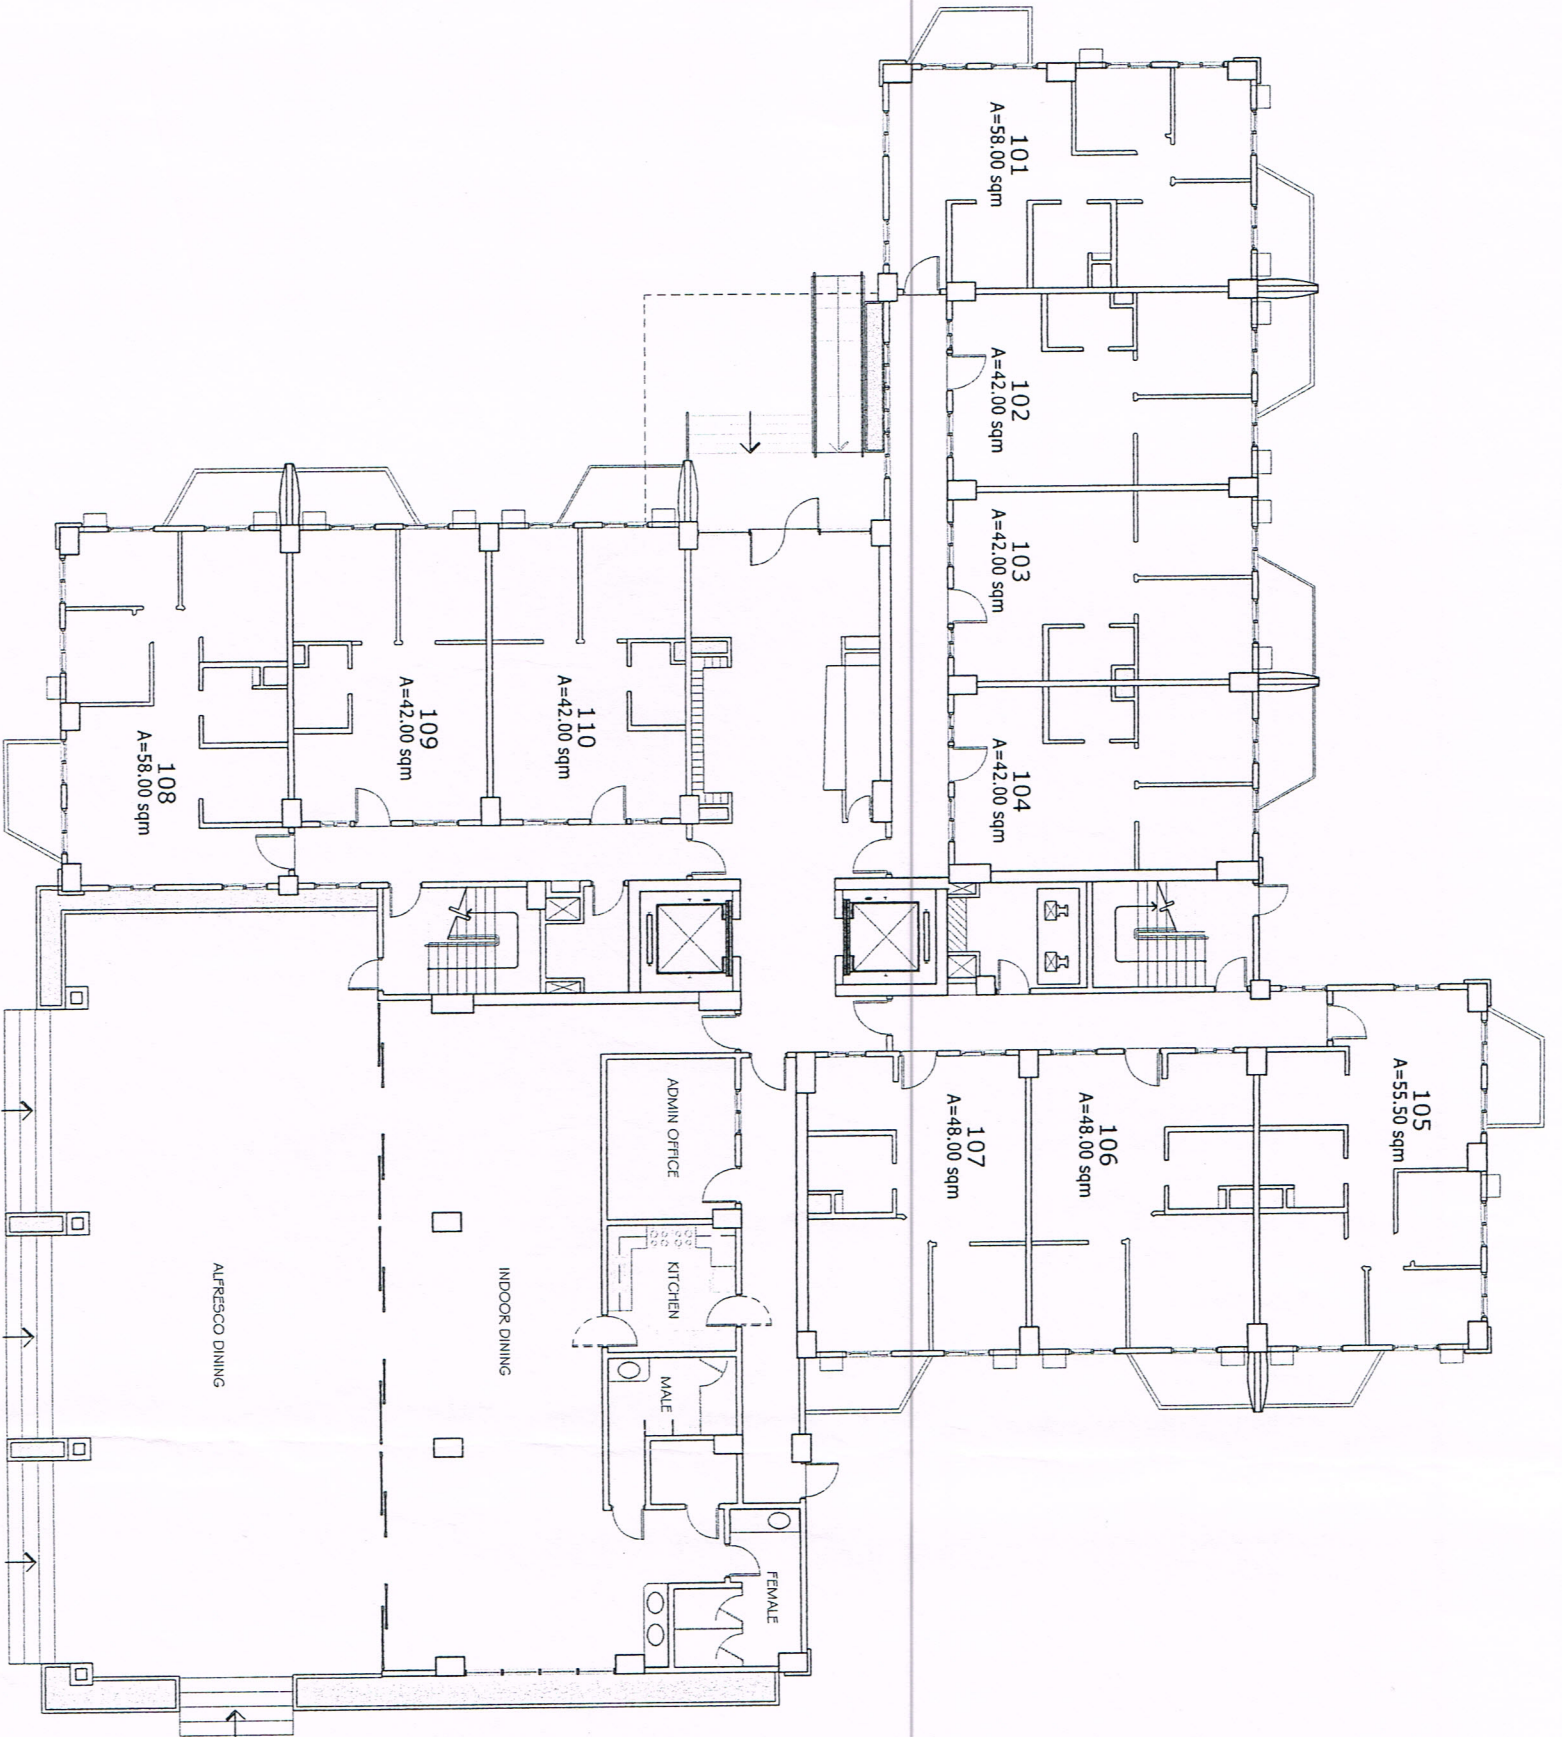


CYPRESS TOWERS TOWER B

GROUND FLOOR PLAN


MARCH 6, 2006

Signature

KEYPLAN

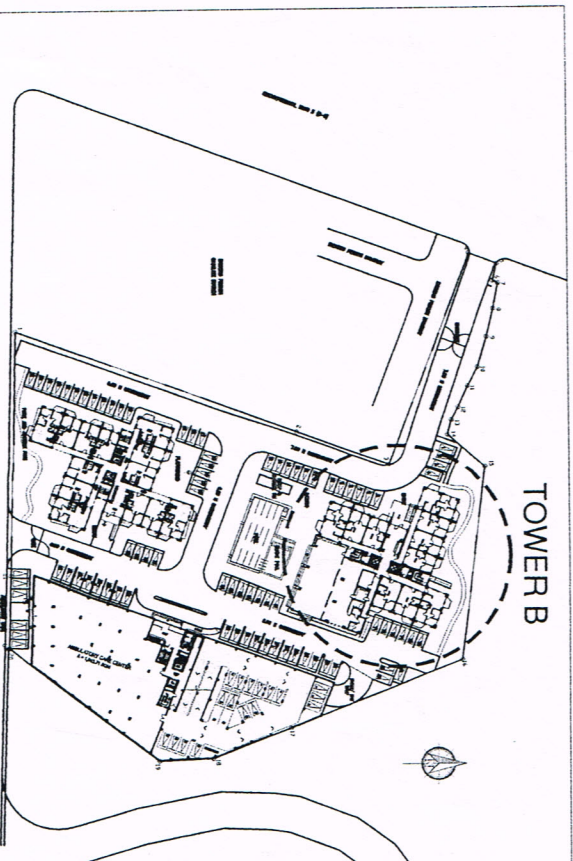


FOR REFERENCE
DATE: 27 JAN 2009

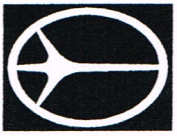

D.M. CONSUNJI, INC.

ENGINEERS · CONTRACTORS

2281 PASONG TAMO EXTENSION, MAKATI CITY
TEL. NO.: 841-0841

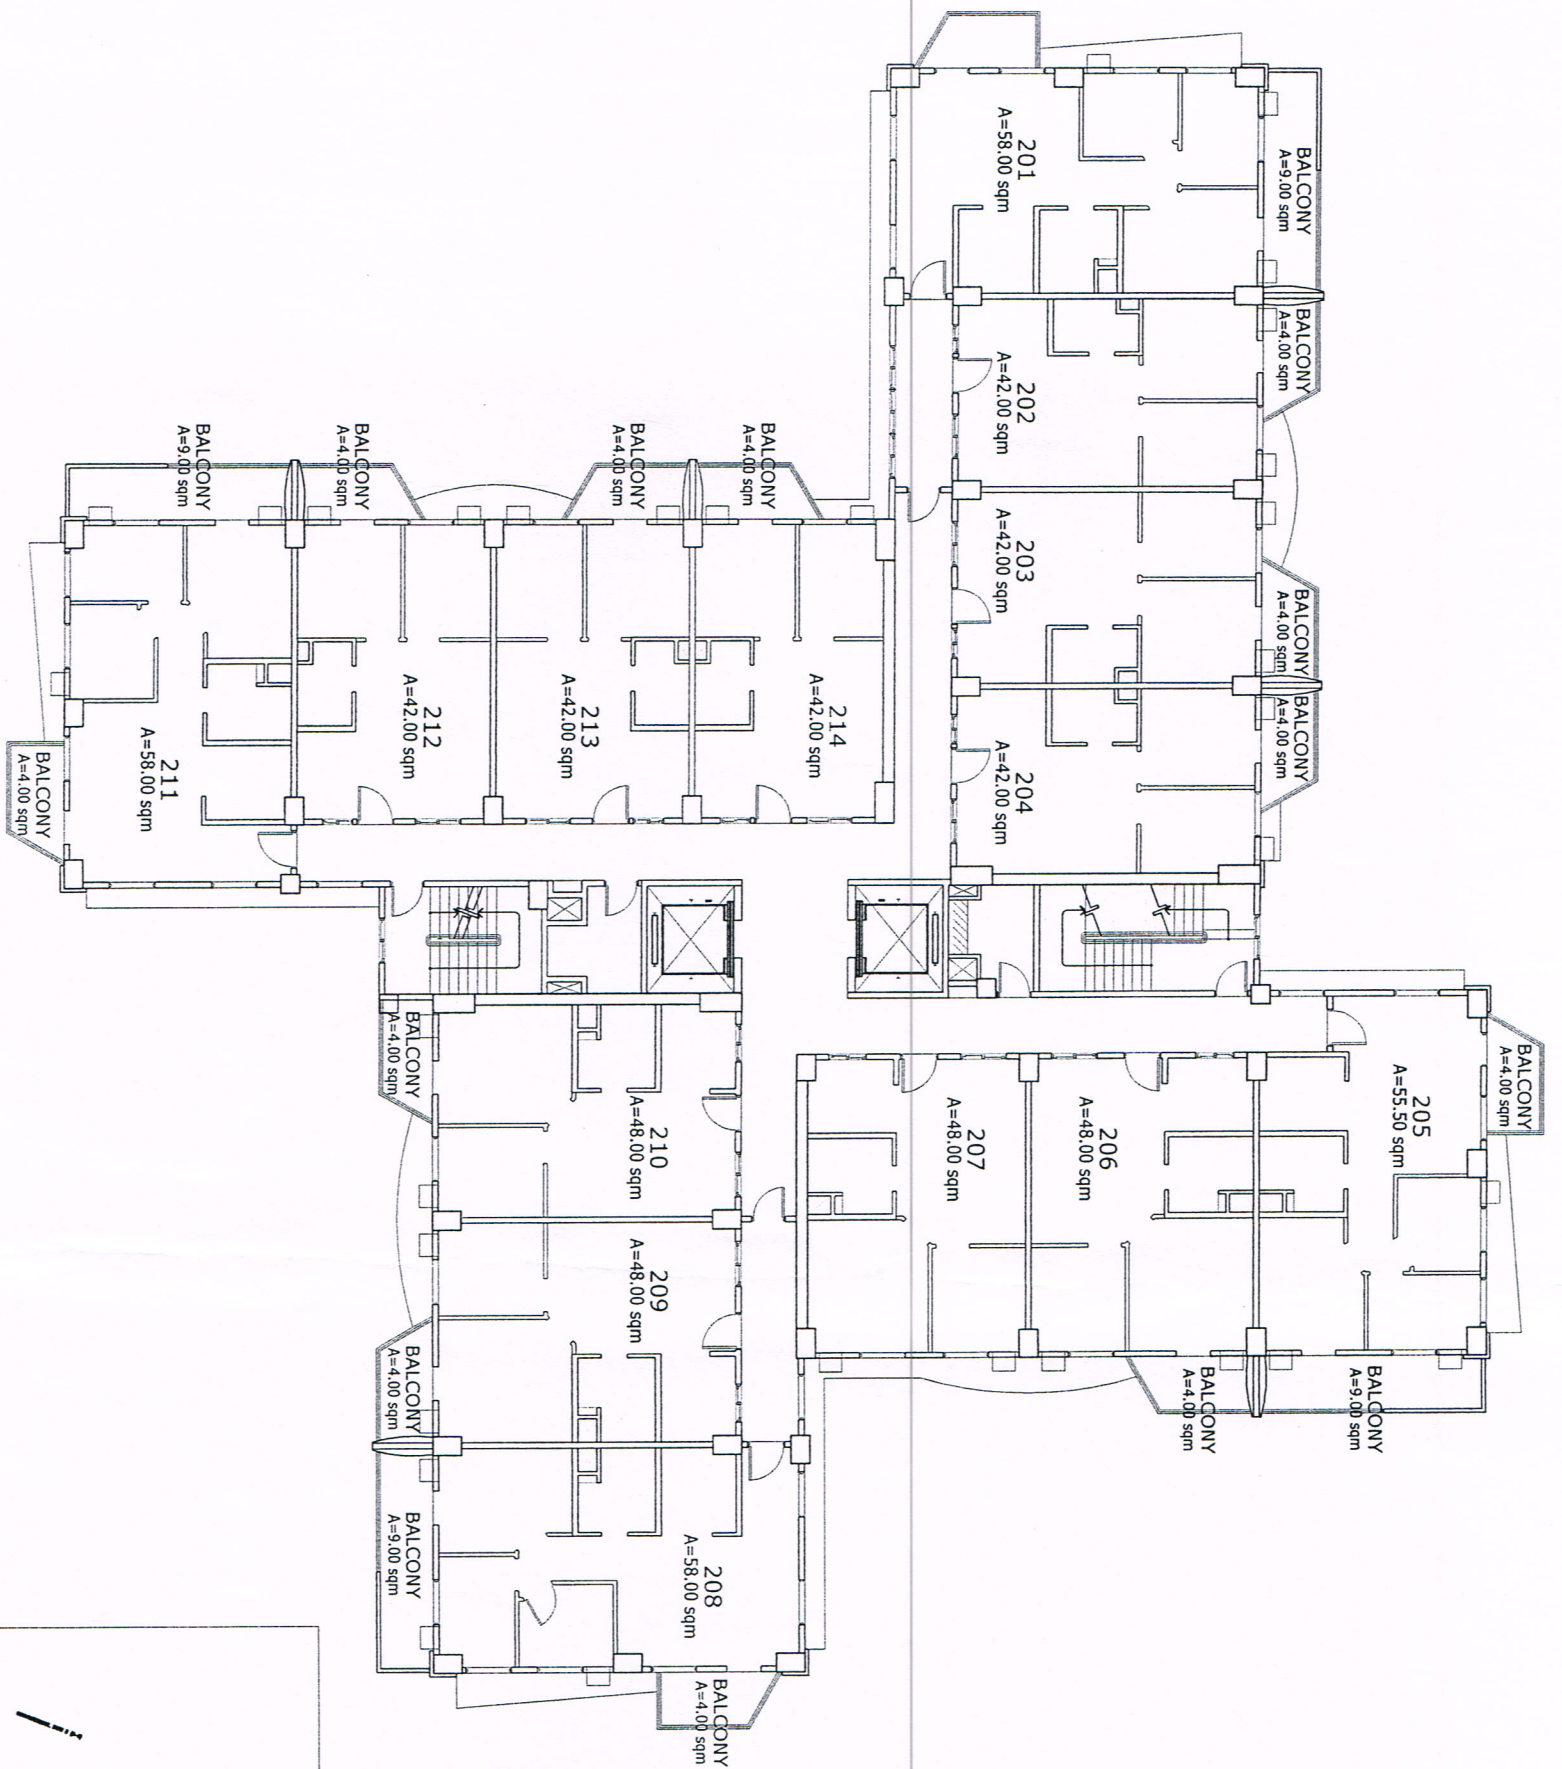


CYPRESS TOWERS TOWER B


SECOND FLOOR PLAN

MARCH 6, 2006

KEYPLAN

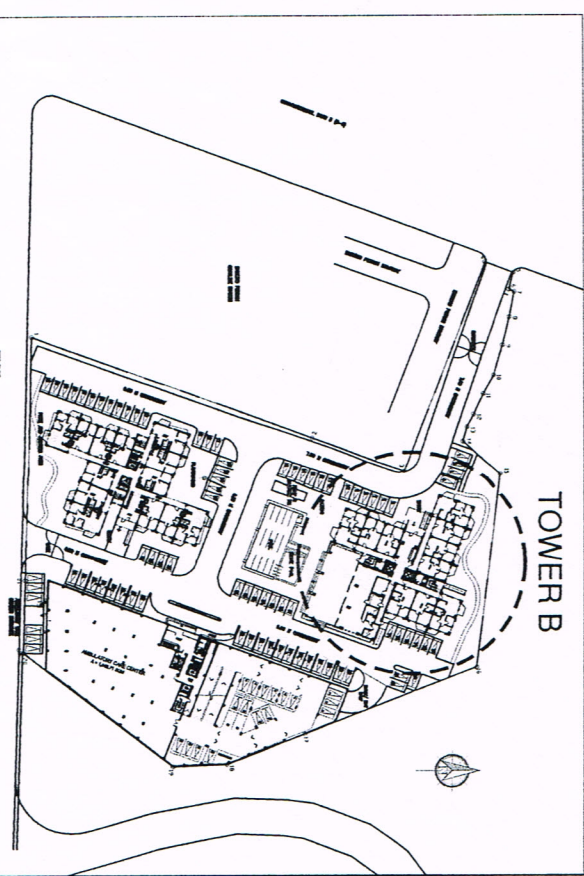

FOR REFERENCE
DATE: JAN 2009

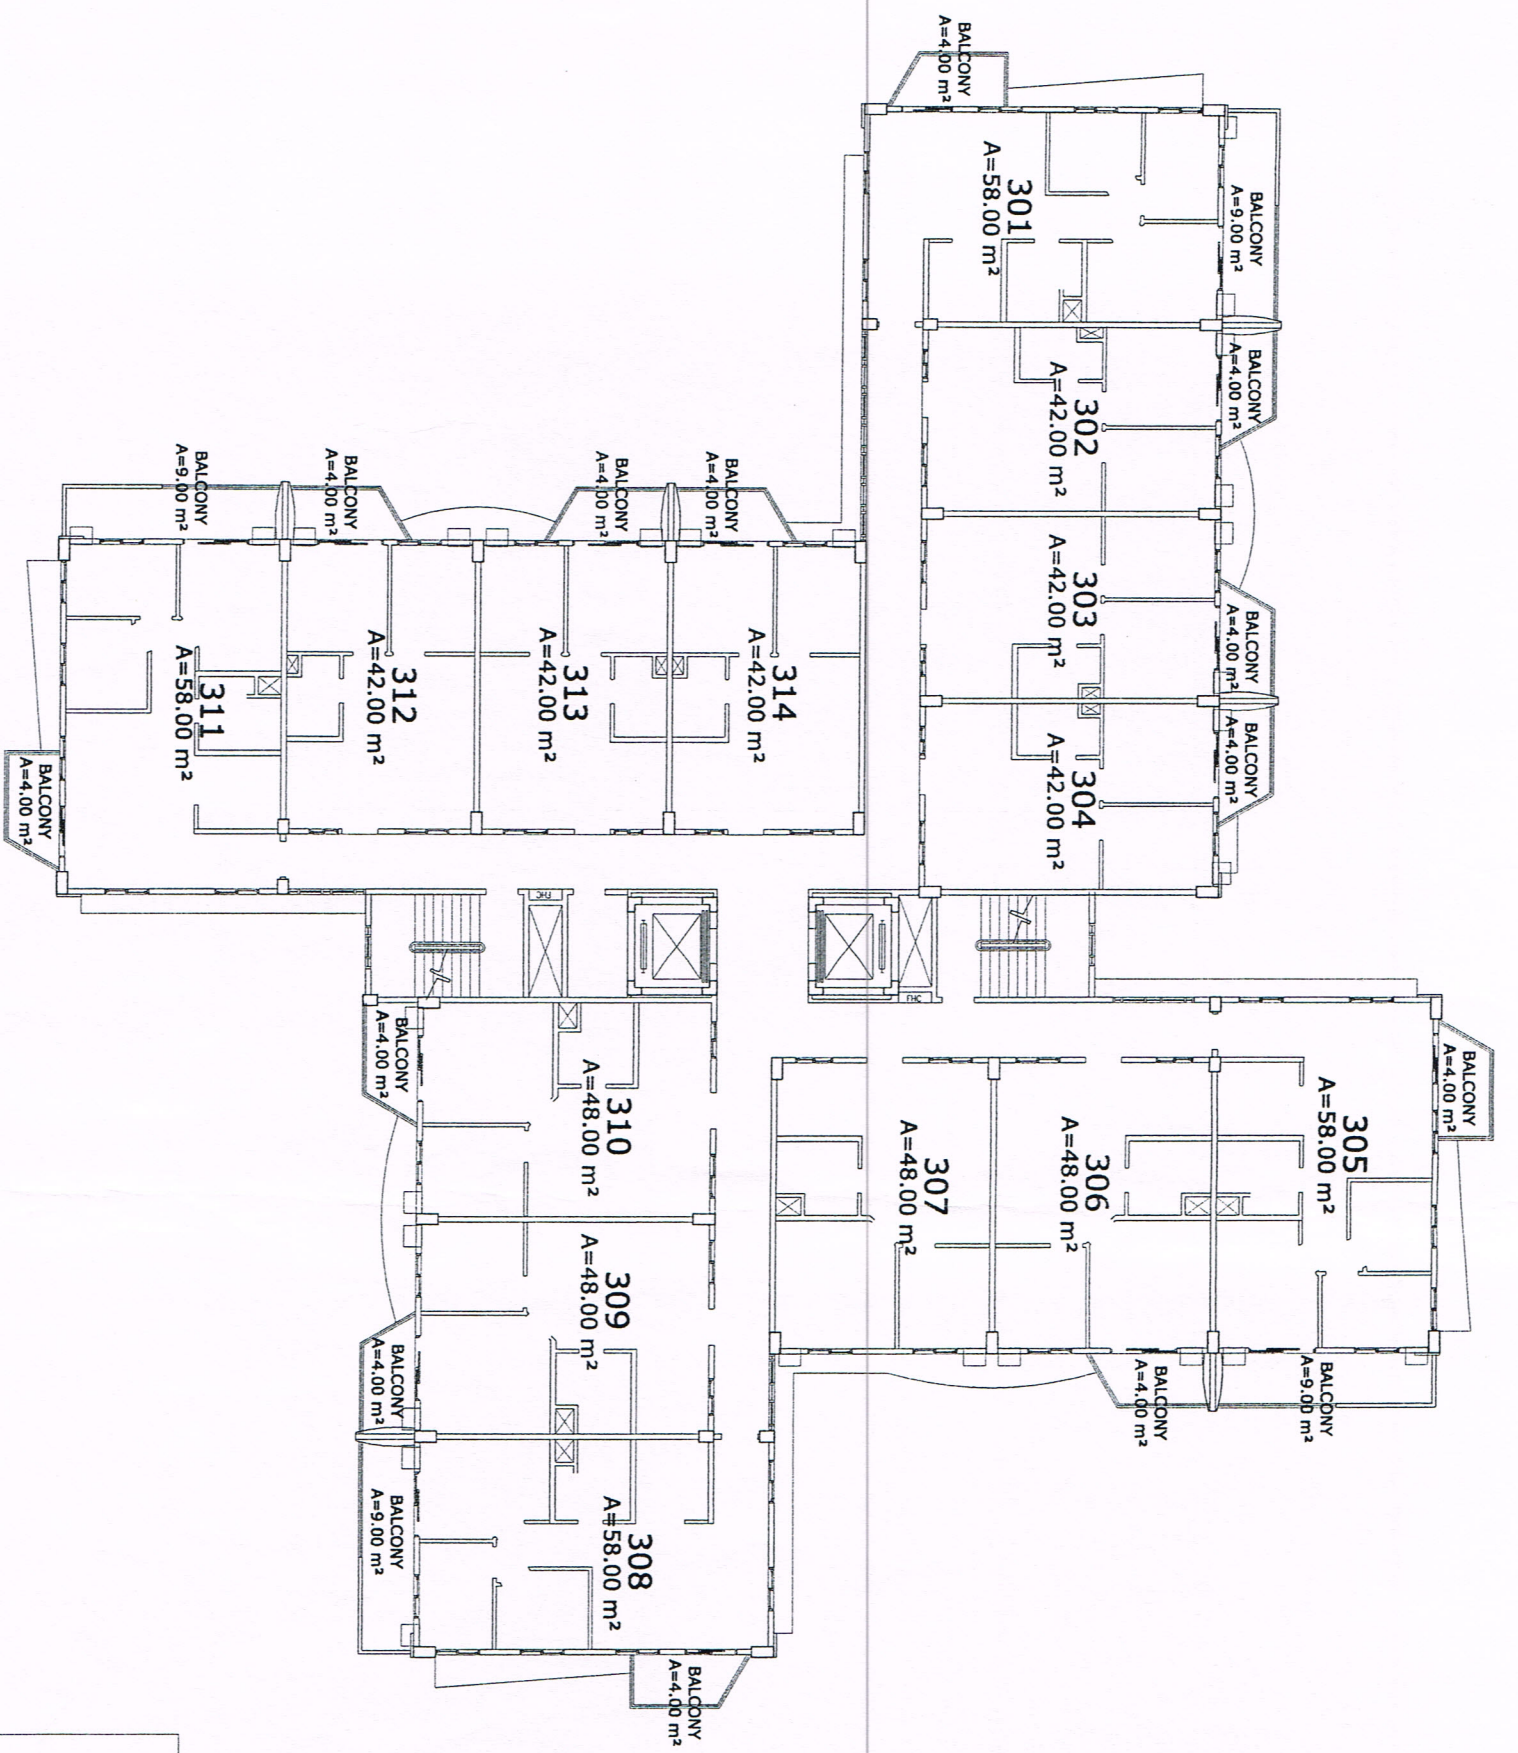



**CYPRESS TOWERS
TOWER B**

THIRD FLOOR PLAN

MARCH 6, 2006

Signature

KEYPLAN

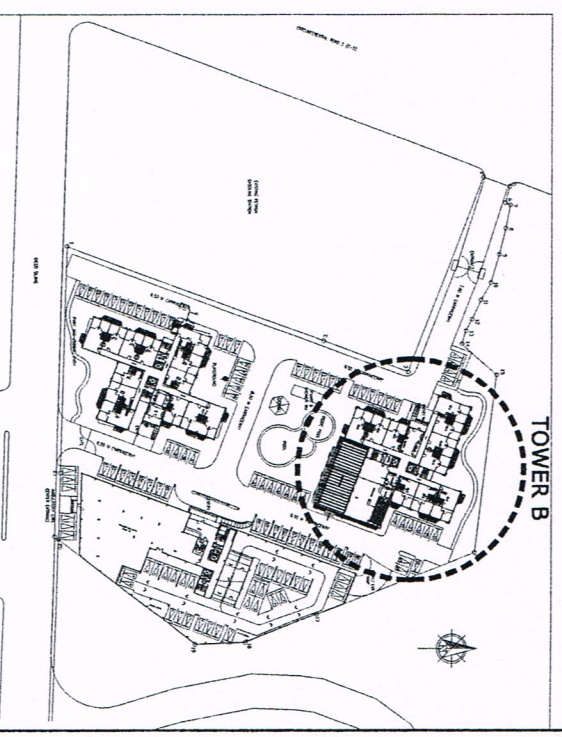


D.M. CONSUNJI, INC.
ENGINEERS • CONTRACTORS

2281 PASONG TAMO EXTENSION, MAKATI CITY
TEL. NO.: 841-0841



D.M. CONSUNJI, INC.
ENGINEERS · CONTRACTORS

2281 PASONG TAMO EXTENSION, MAKATI CITY
TEL. NO.: 841-0841

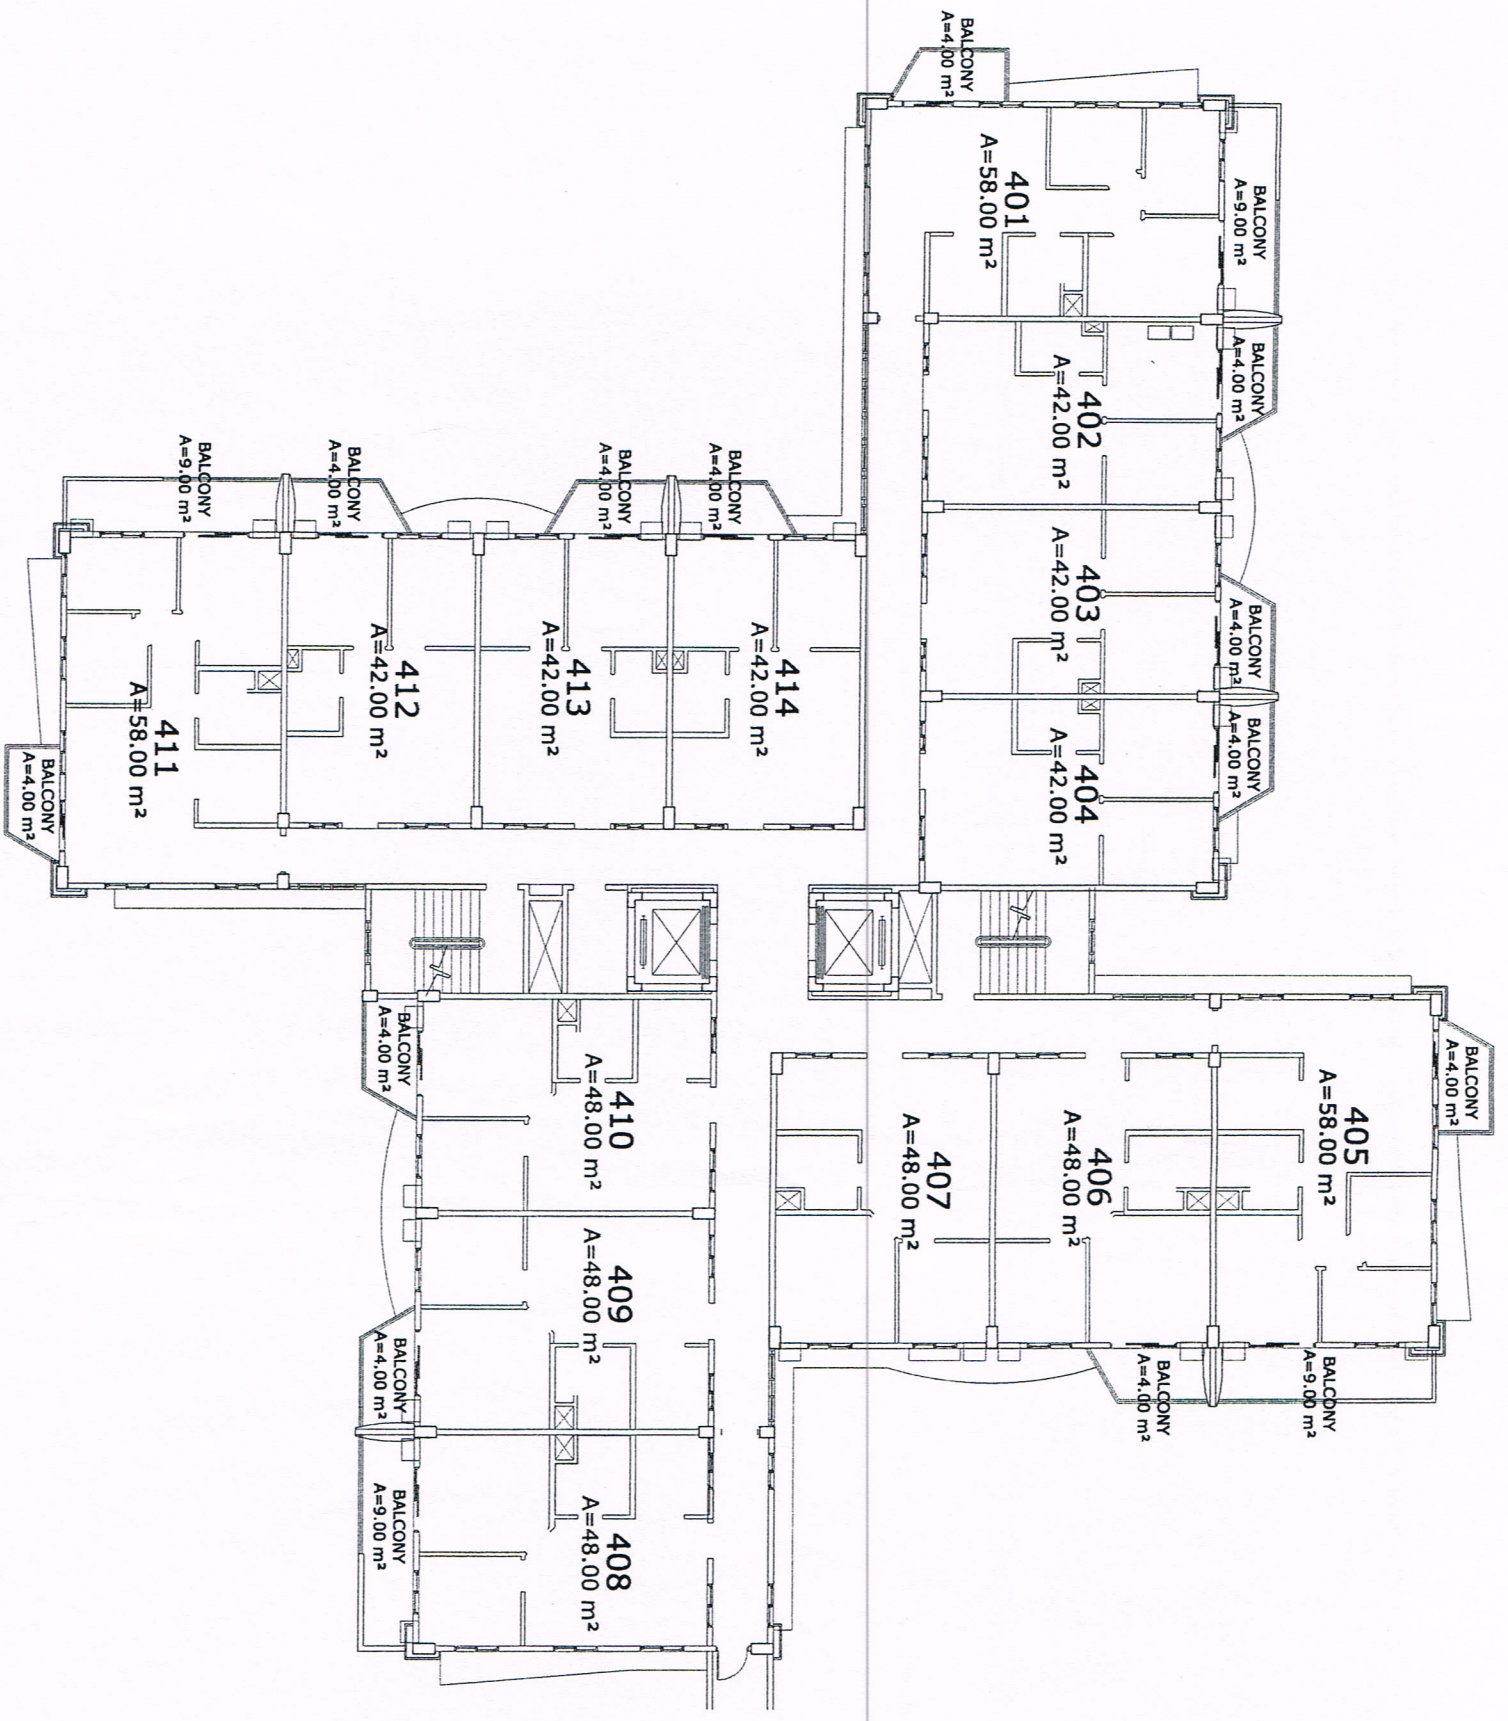


**CYPRESS TOWERS
TOWER B**


FOURTH FLOOR PLAN

MARCH 6, 2006

Sanjiv

KEYPLAN

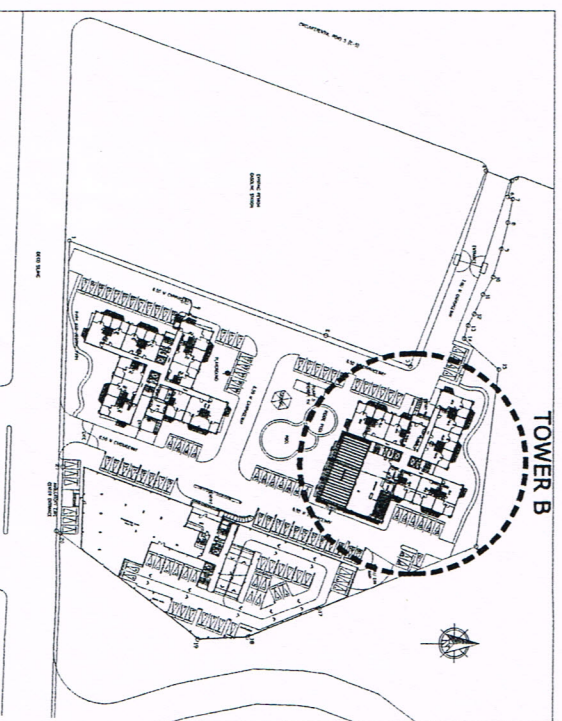

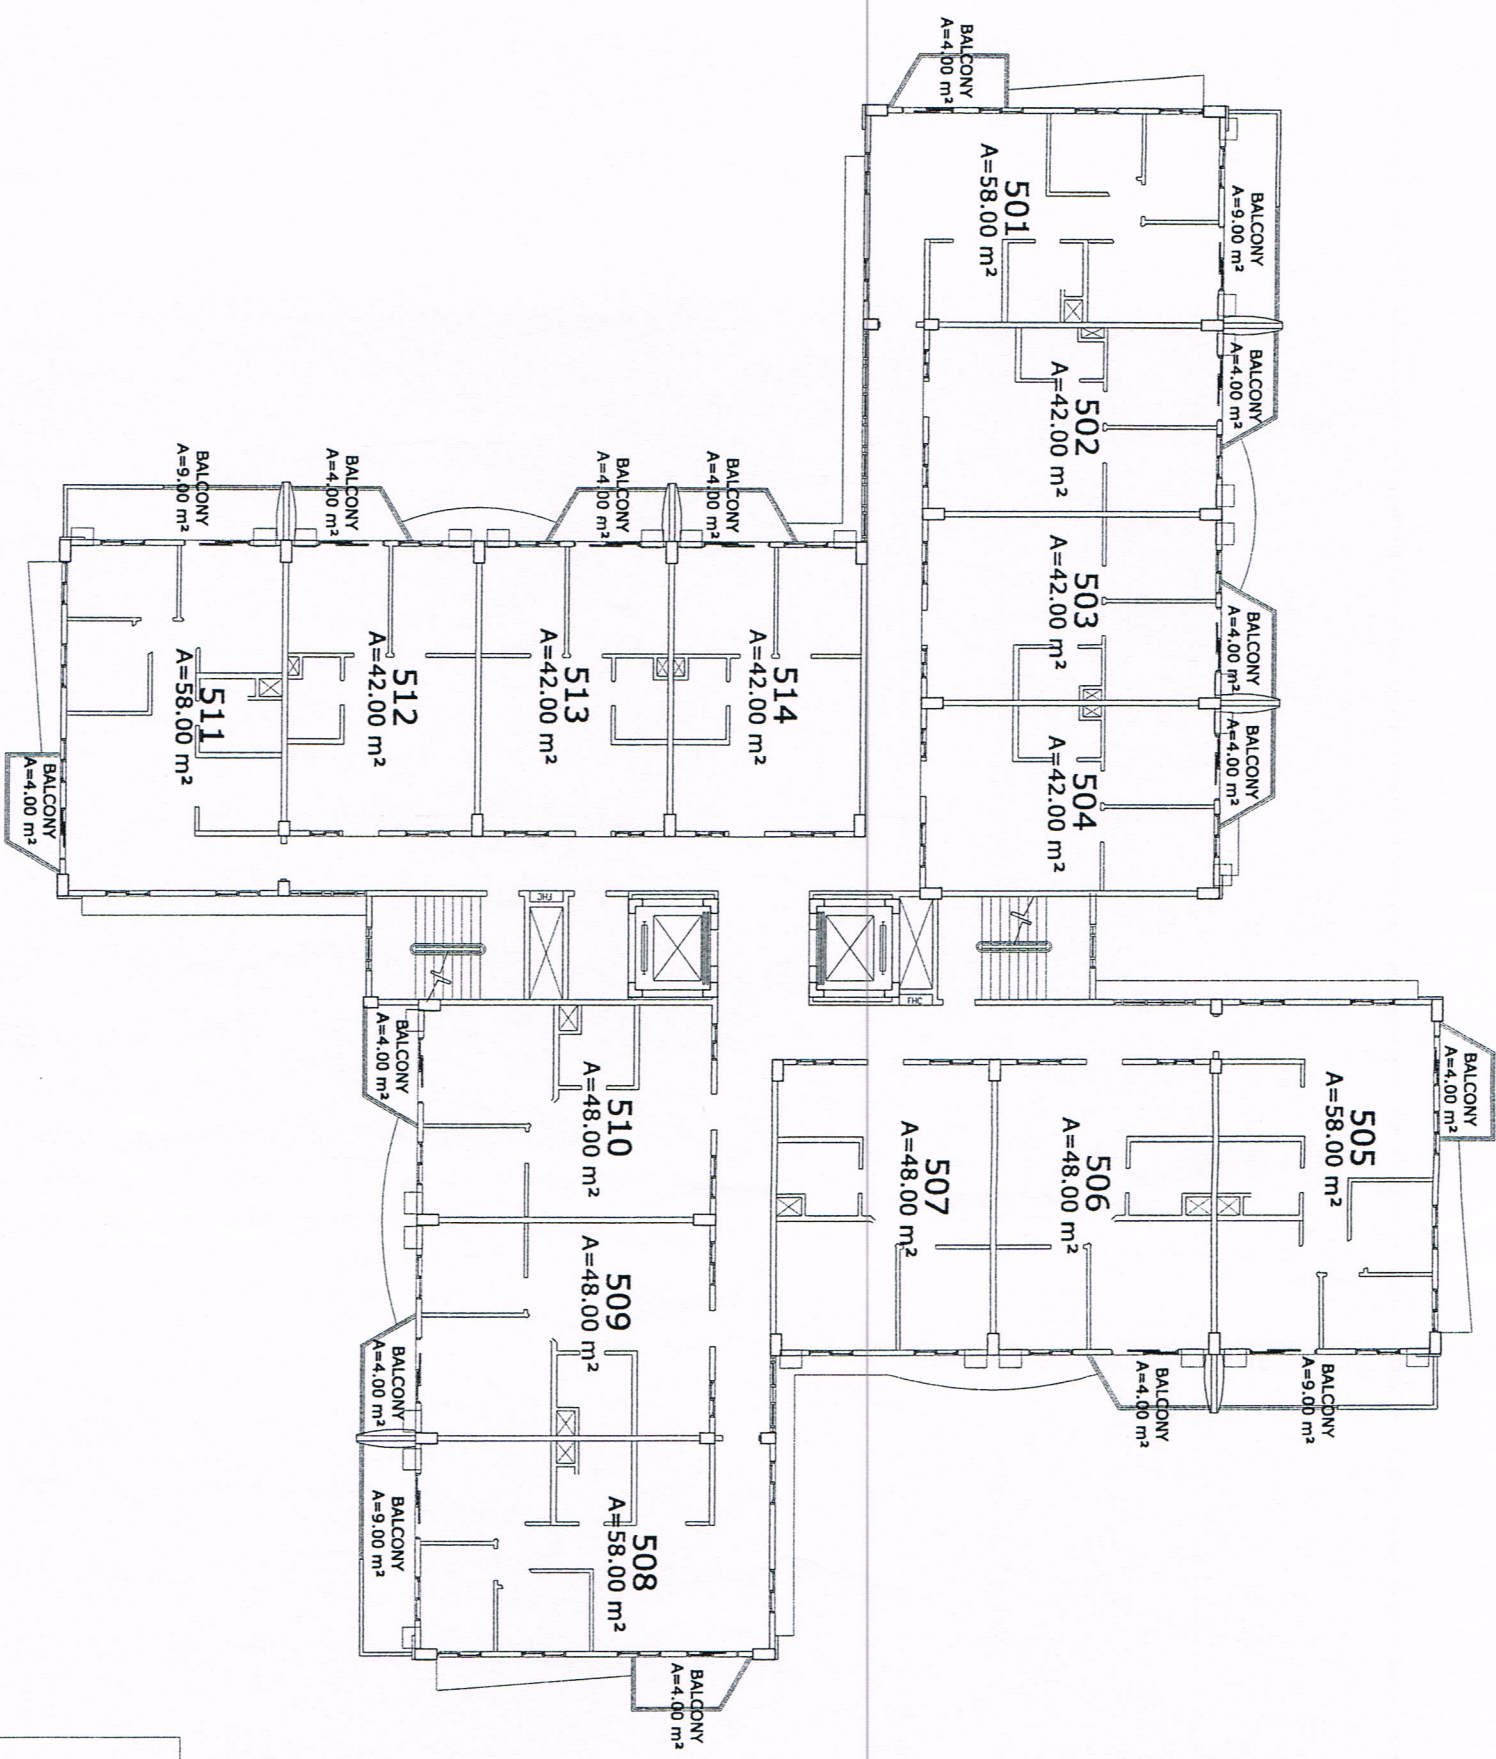



CYPRESS TOWERS
TOWER B

FIFTH FLOOR PLAN

MARCH 6, 2006

Signature

KEYPLAN

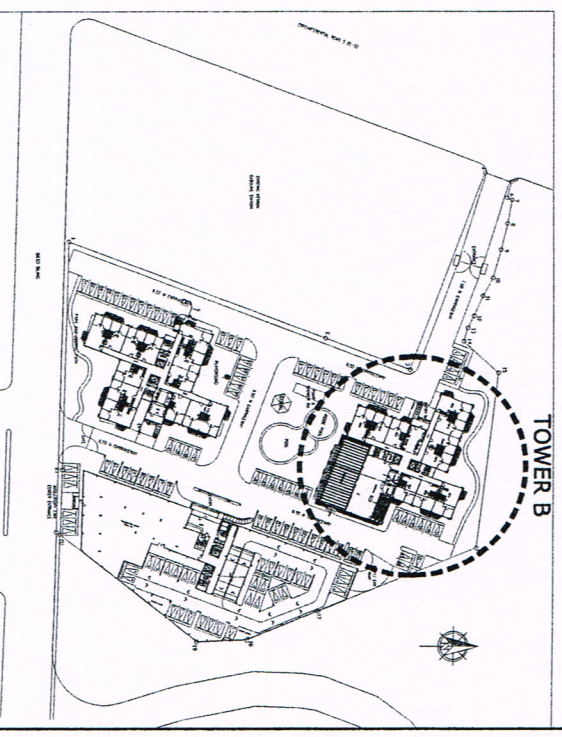

D.M. CONSUNJI, INC.

ENGINEERS • CONTRACTORS

2281 PASONG TAMO EXTENSION, MAKATI CITY
 TEL. NO.: 841-0841



D.M. CONSUNJI, INC.

ENGINEERS • CONTRACTORS


2281 PASONG TAMO EXTENSION, MAKATI CITY
TEL. NO.: 841-0841

CYPRESS TOWERS
TOWER B


SIXTH FLOOR PLAN


MARCH 6, 2006

Quison

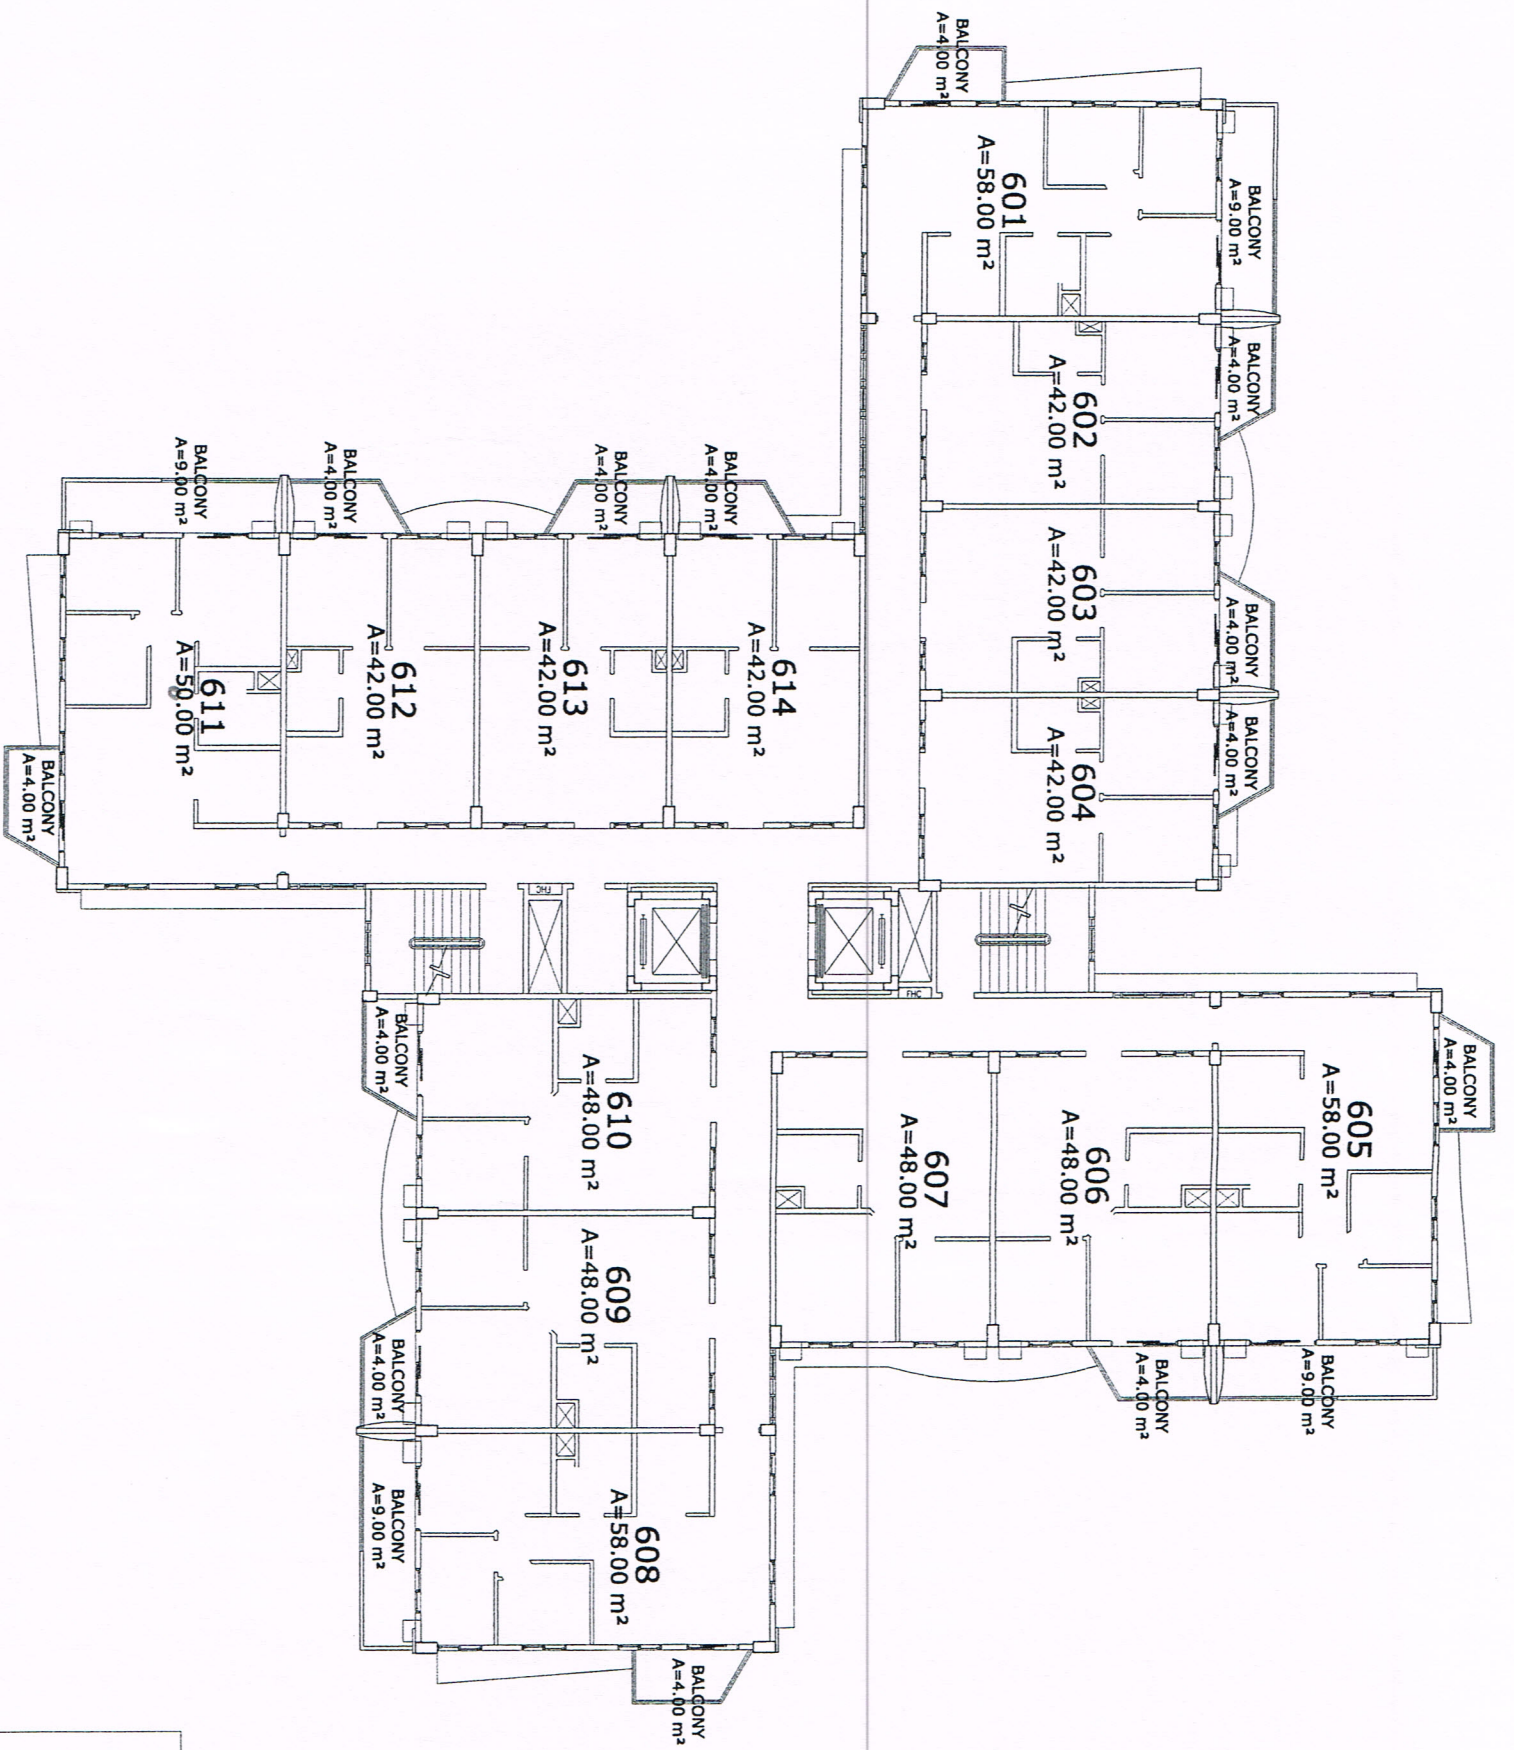

KEYPLAN

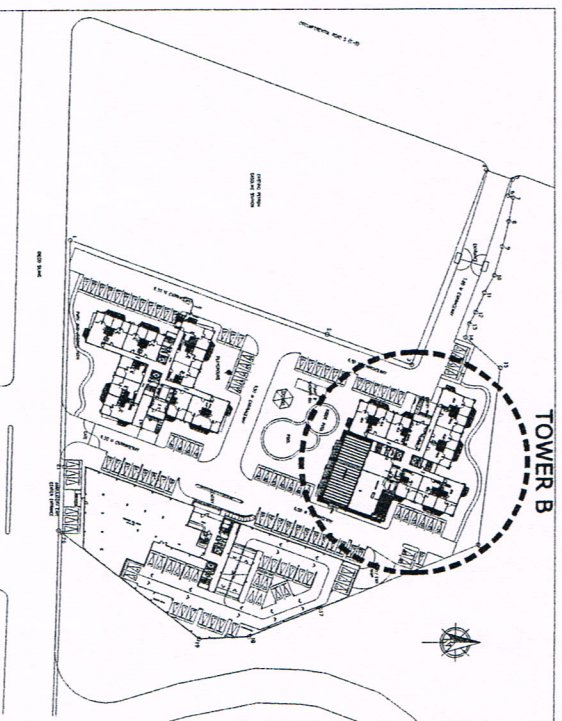

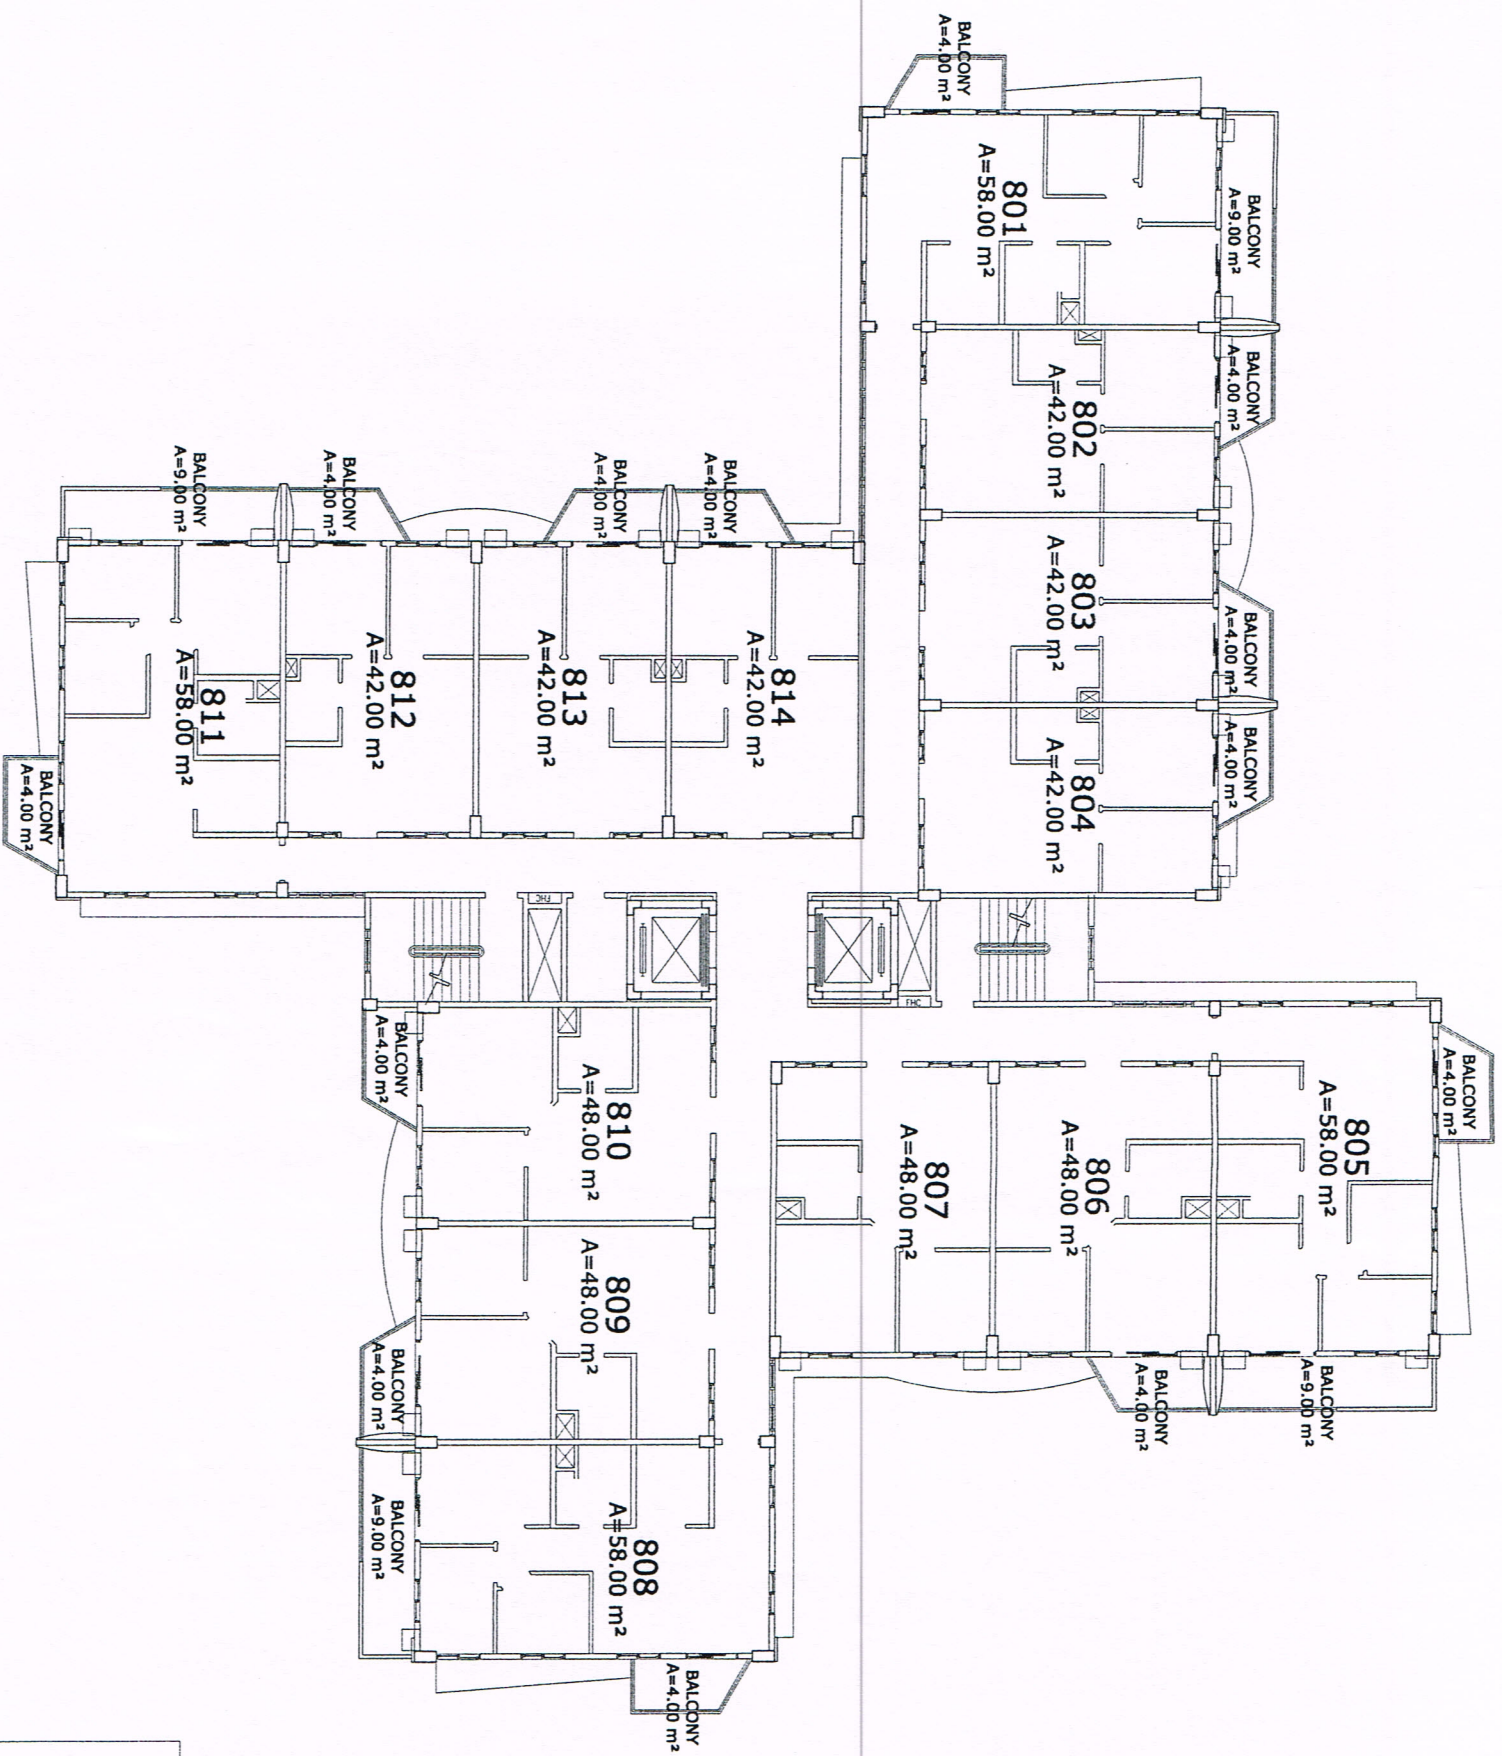


**CYPRESS TOWERS
TOWER B**

EIGHTH FLOOR PLAN

MARCH 6, 2006


gibson

KEYPLAN

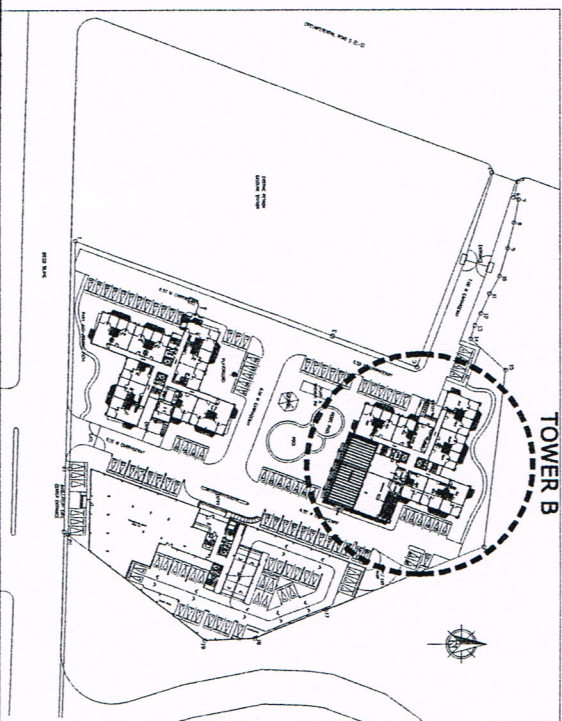

D.M. CONSUNJI, INC.
ENGINEERS • CONTRACTORS

2281 PASONG TAMO EXTENSION, MAKATI CITY
TEL. NO.: 841-0841

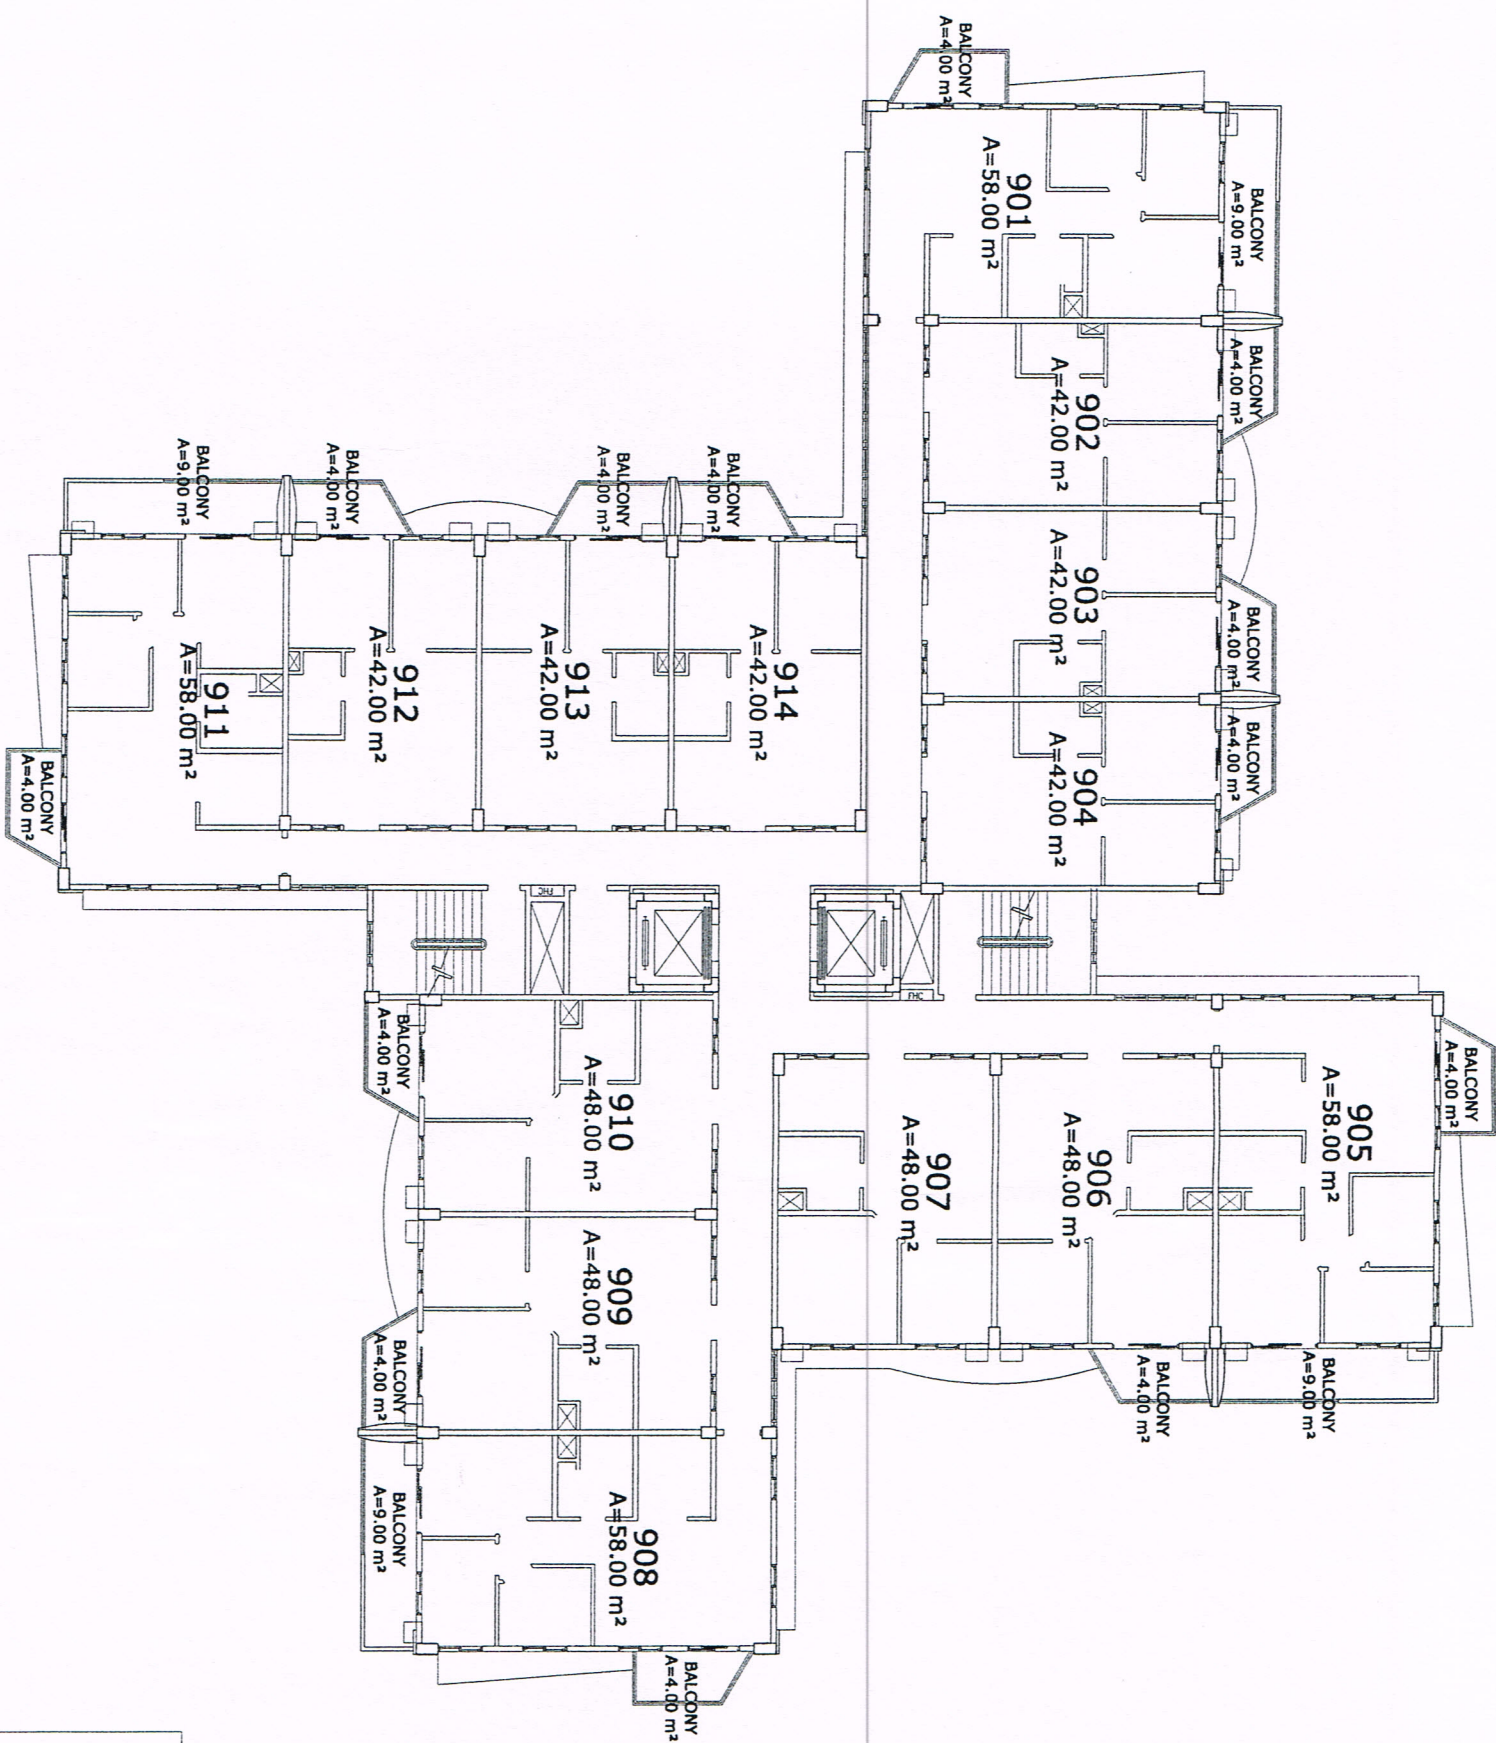



**CYPRESS TOWERS
TOWER B**

NINTH FLOOR PLAN

MARCH 6, 2006

Signature


KEYPLAN

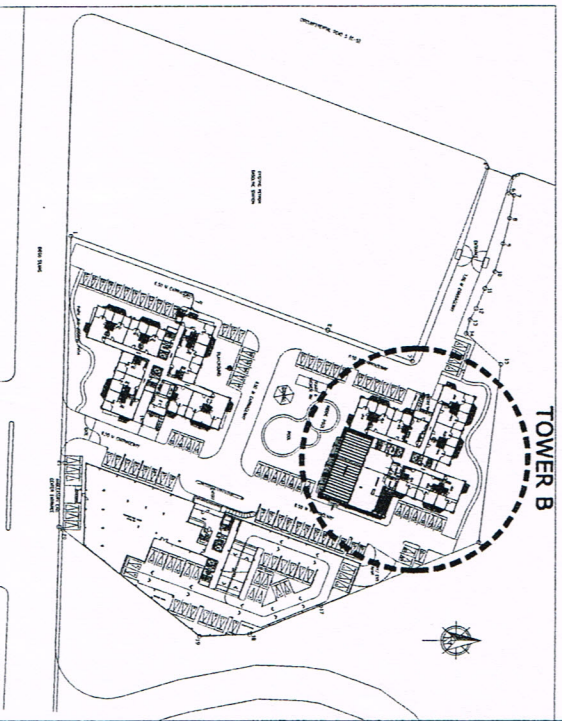

D.M. CONSUNJI, INC.

ENGINEERS • CONTRACTORS

2281 PASONG TAMO EXTENSION, MAKATI CITY
TEL. NO.: 841-0841

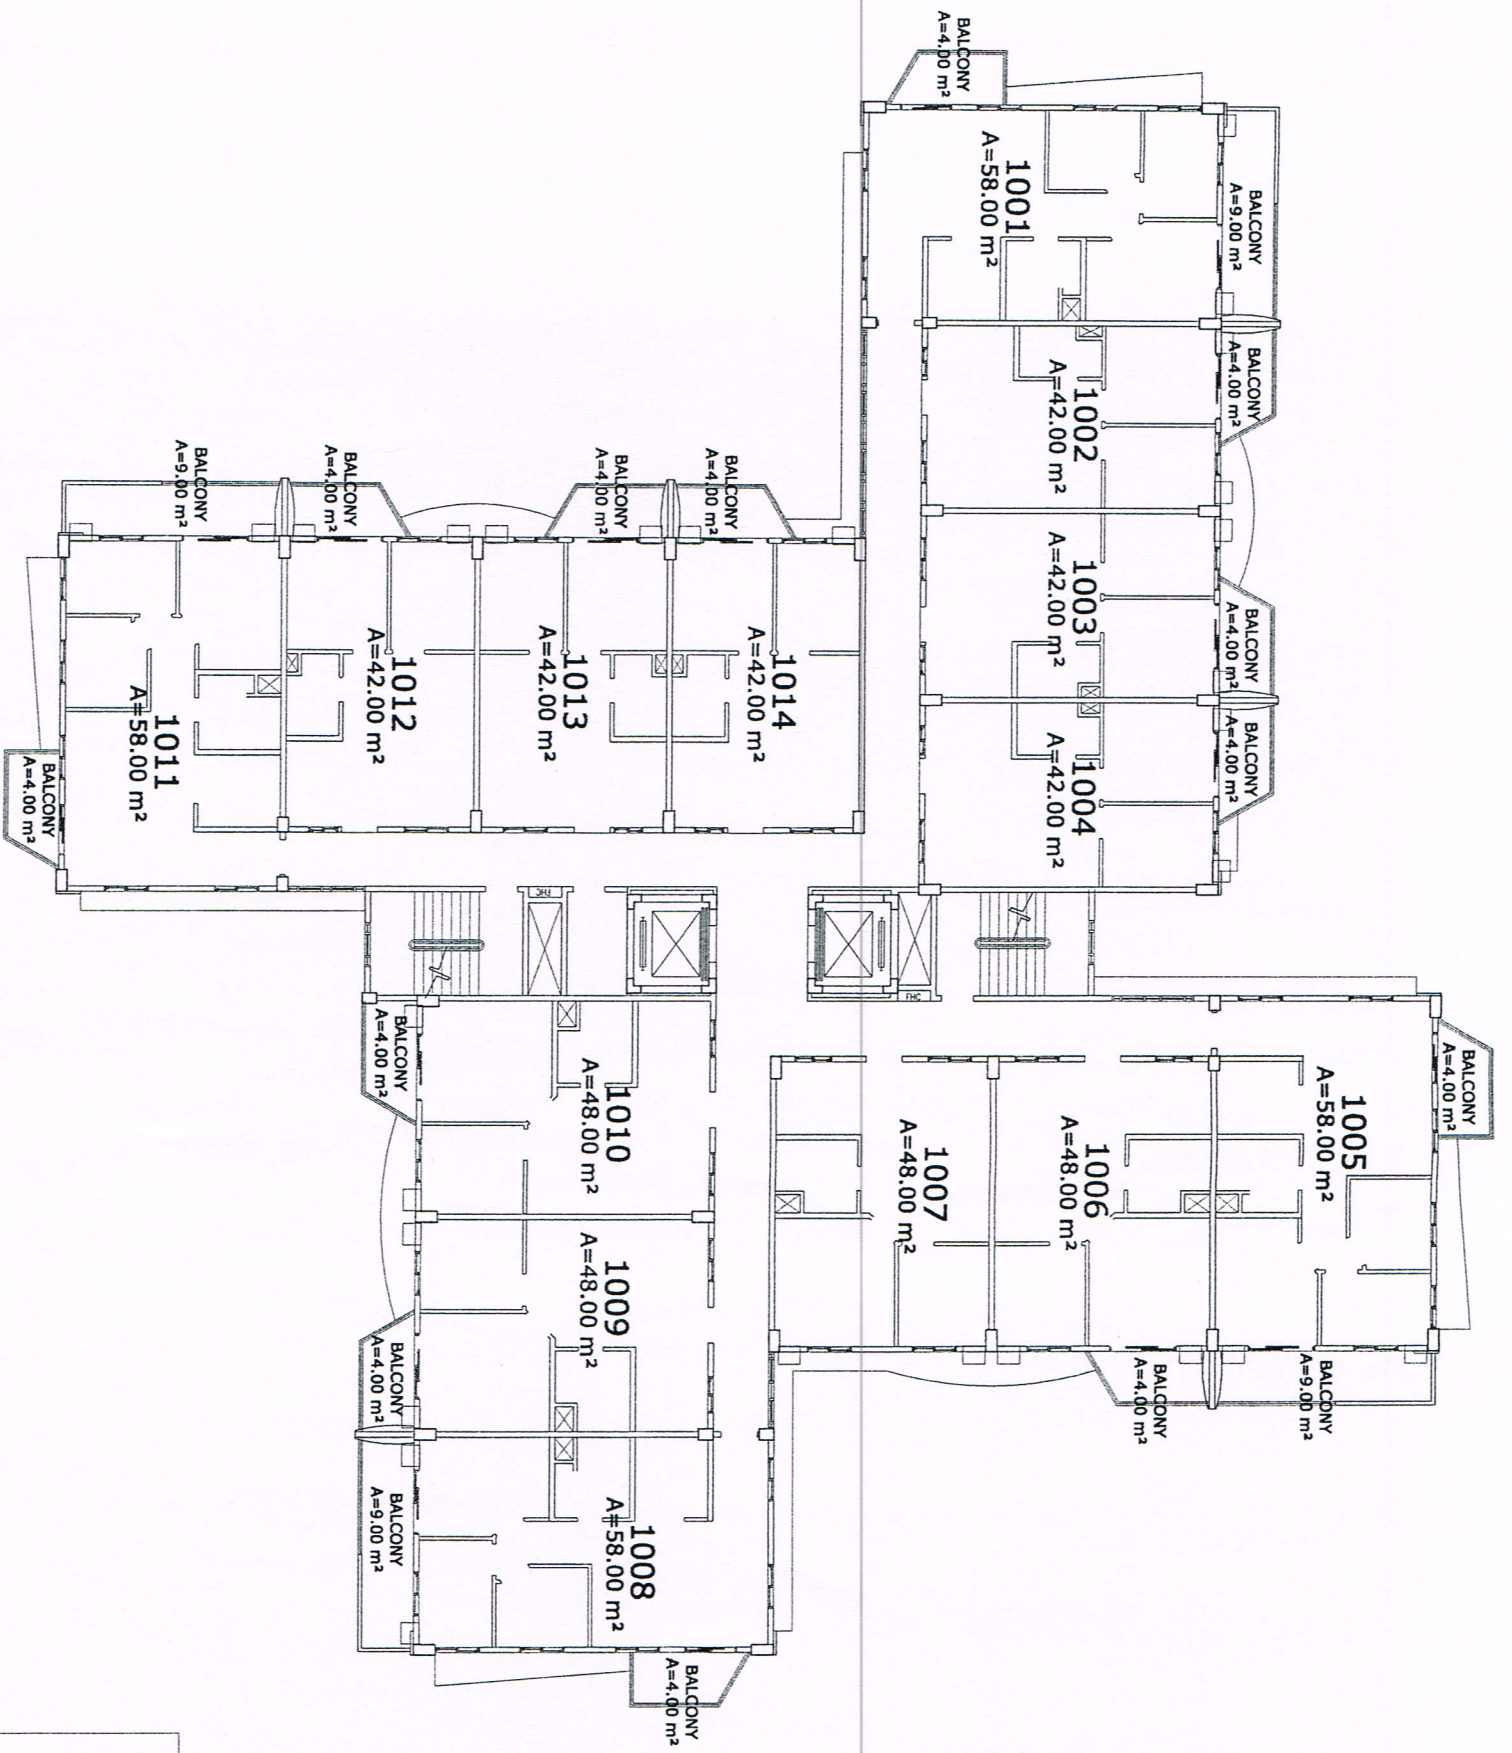



**CYPRESS TOWERS
TOWER B**

TENTH FLOOR PLAN
g/bn

MARCH 6, 2006

KEYPLAN

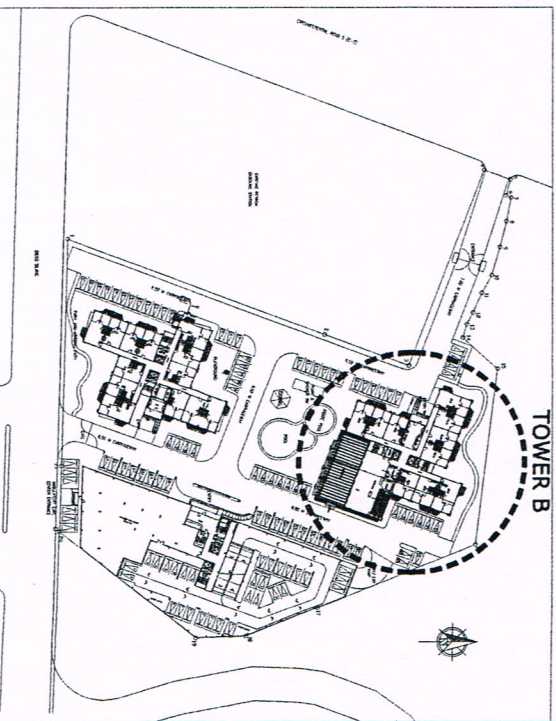

D.M. CONSUNJI, INC.


ENGINEERS • CONTRACTORS

2281 PASONG TAMO EXTENSION, MAKATI CITY
TEL. NO.: 841-0841



D.M. CONSUNJI, INC.
ENGINEERS · CONTRACTORS

2281 PASONG TAMO EXTENSION, MAKATI CITY
TEL. NO.: 841-0841

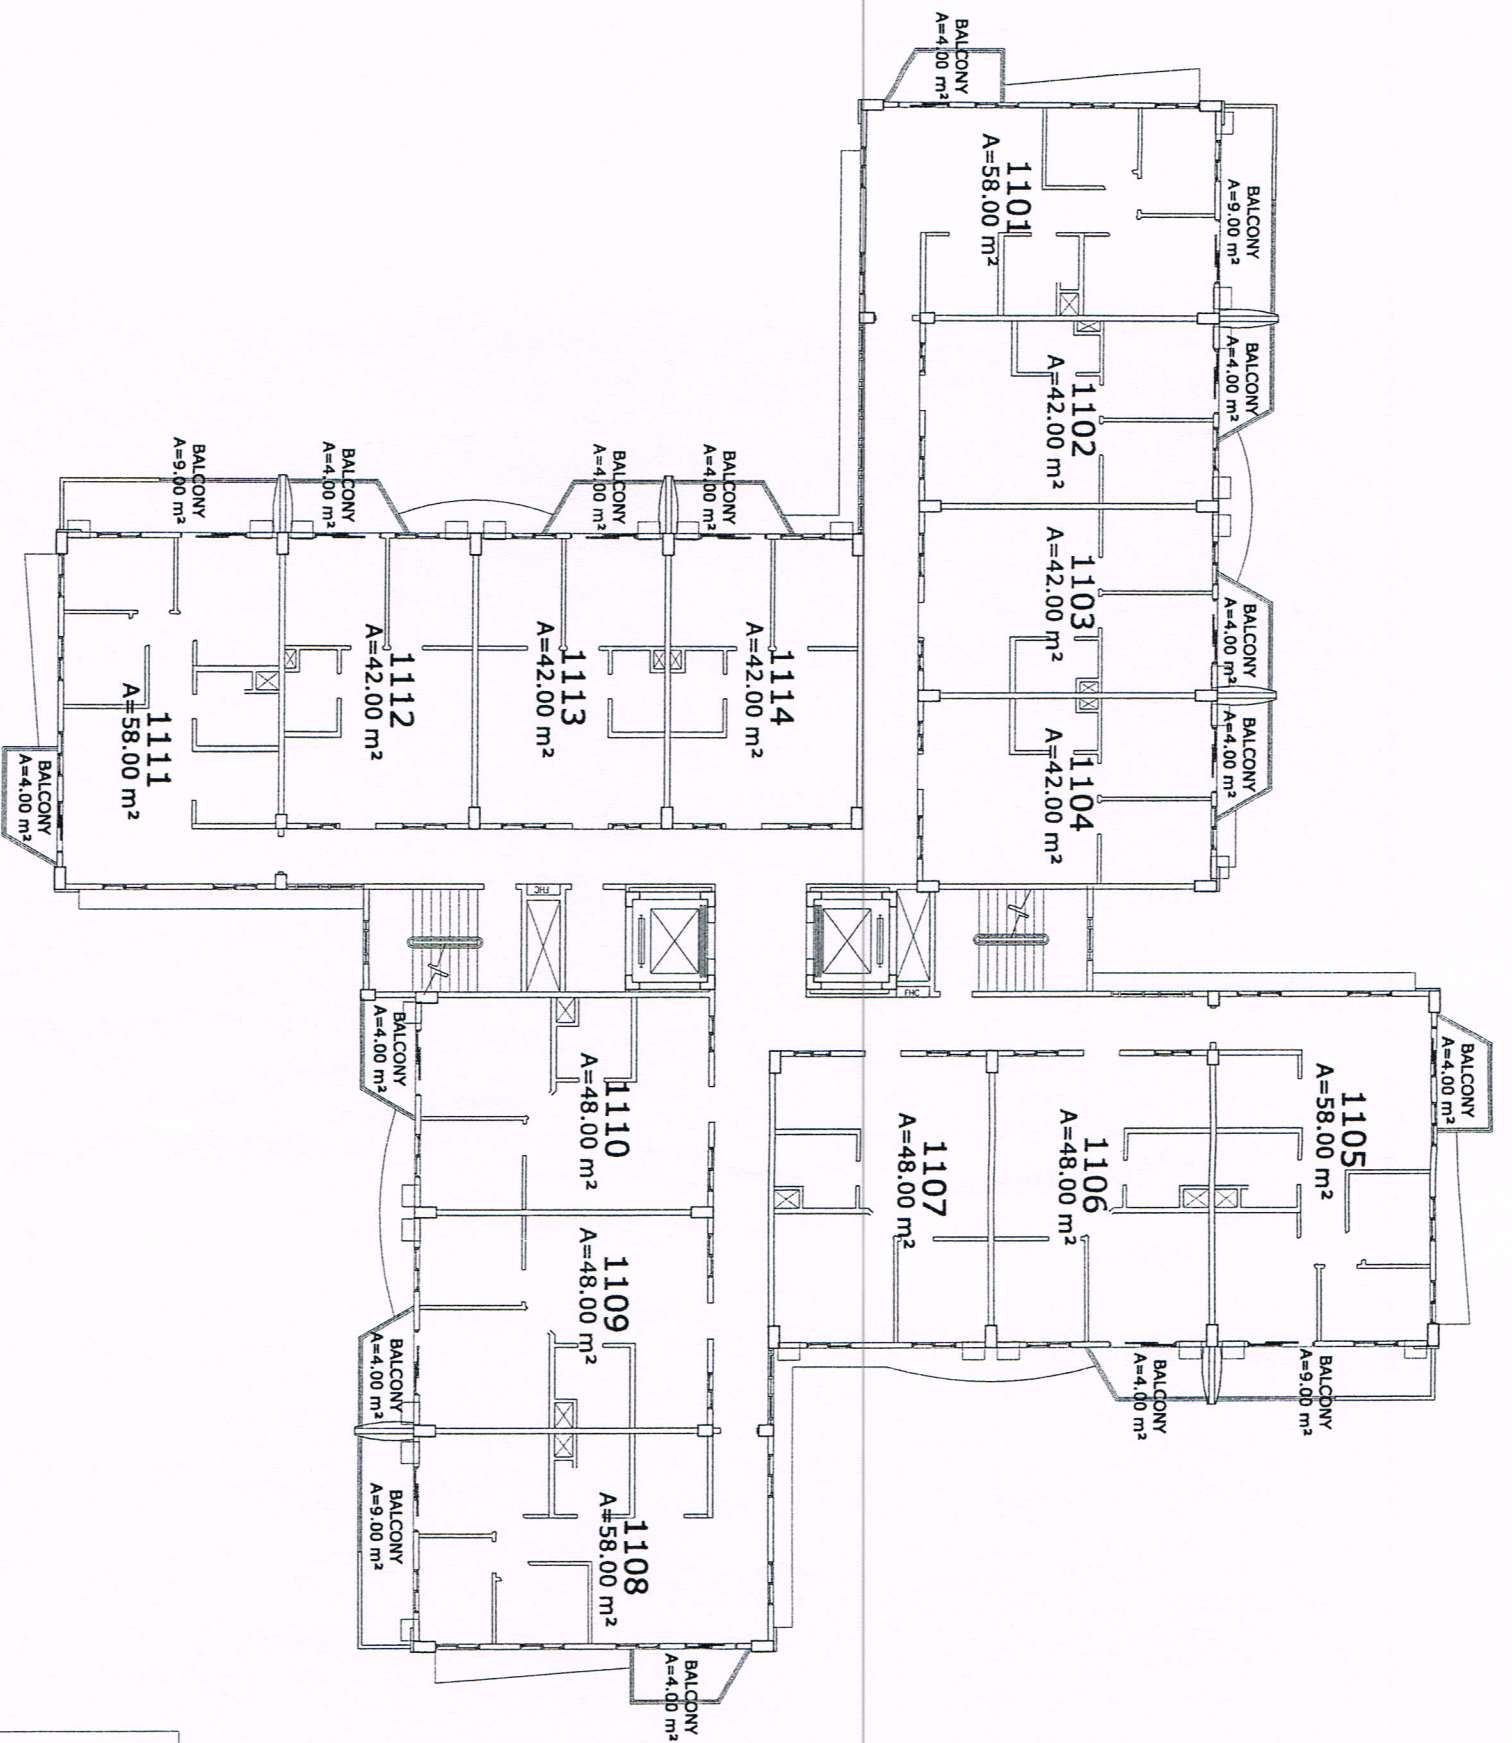


**CYPRESS TOWERS
TOWER B**


11TH FLOOR PLAN

MARCH 6, 2006

am
am

KEYPLAN

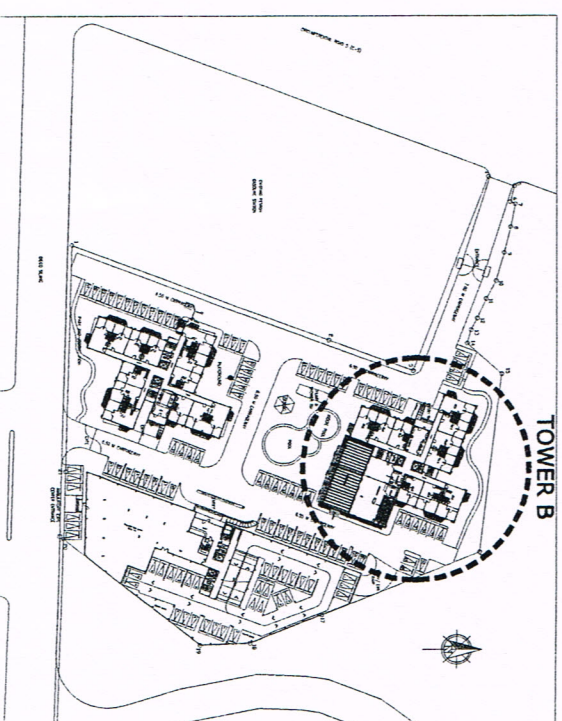

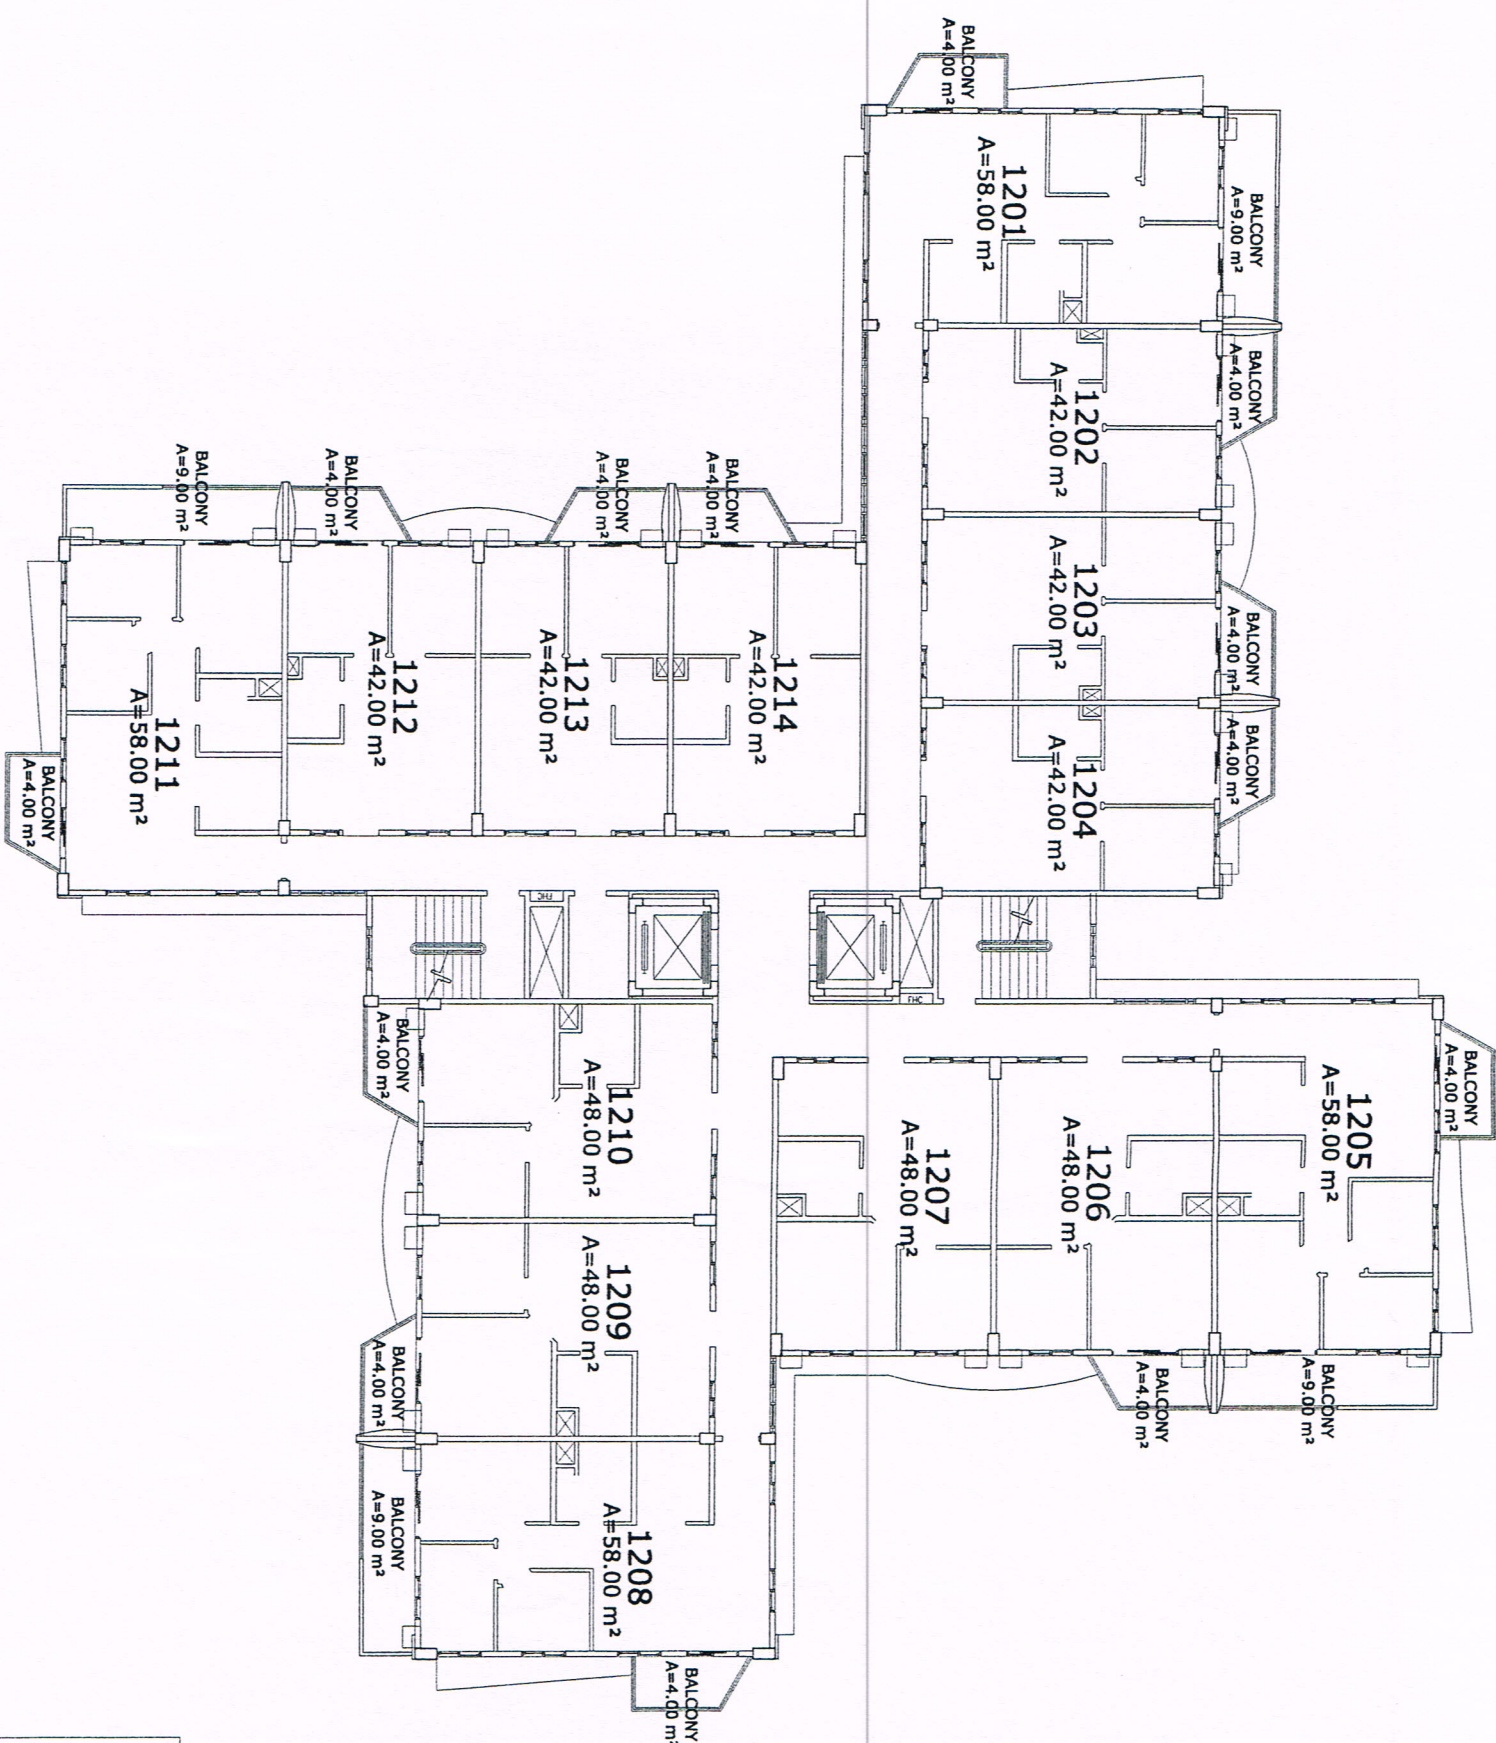



**CYPRESS TOWERS
TOWER B**


12TH FLOOR PLAN


MARCH 6, 2006

QIBN

KEYPLAN

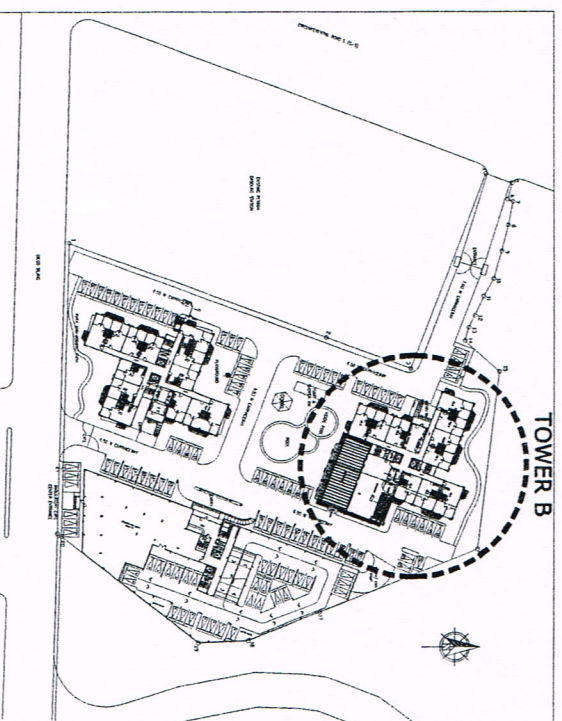


D.M. CONSUNJI, INC.
 ENGINEERS • CONTRACTORS
 2281 PASONG TAMO EXTENSION, MAKATI CITY
 TEL. NO.: 841-0841

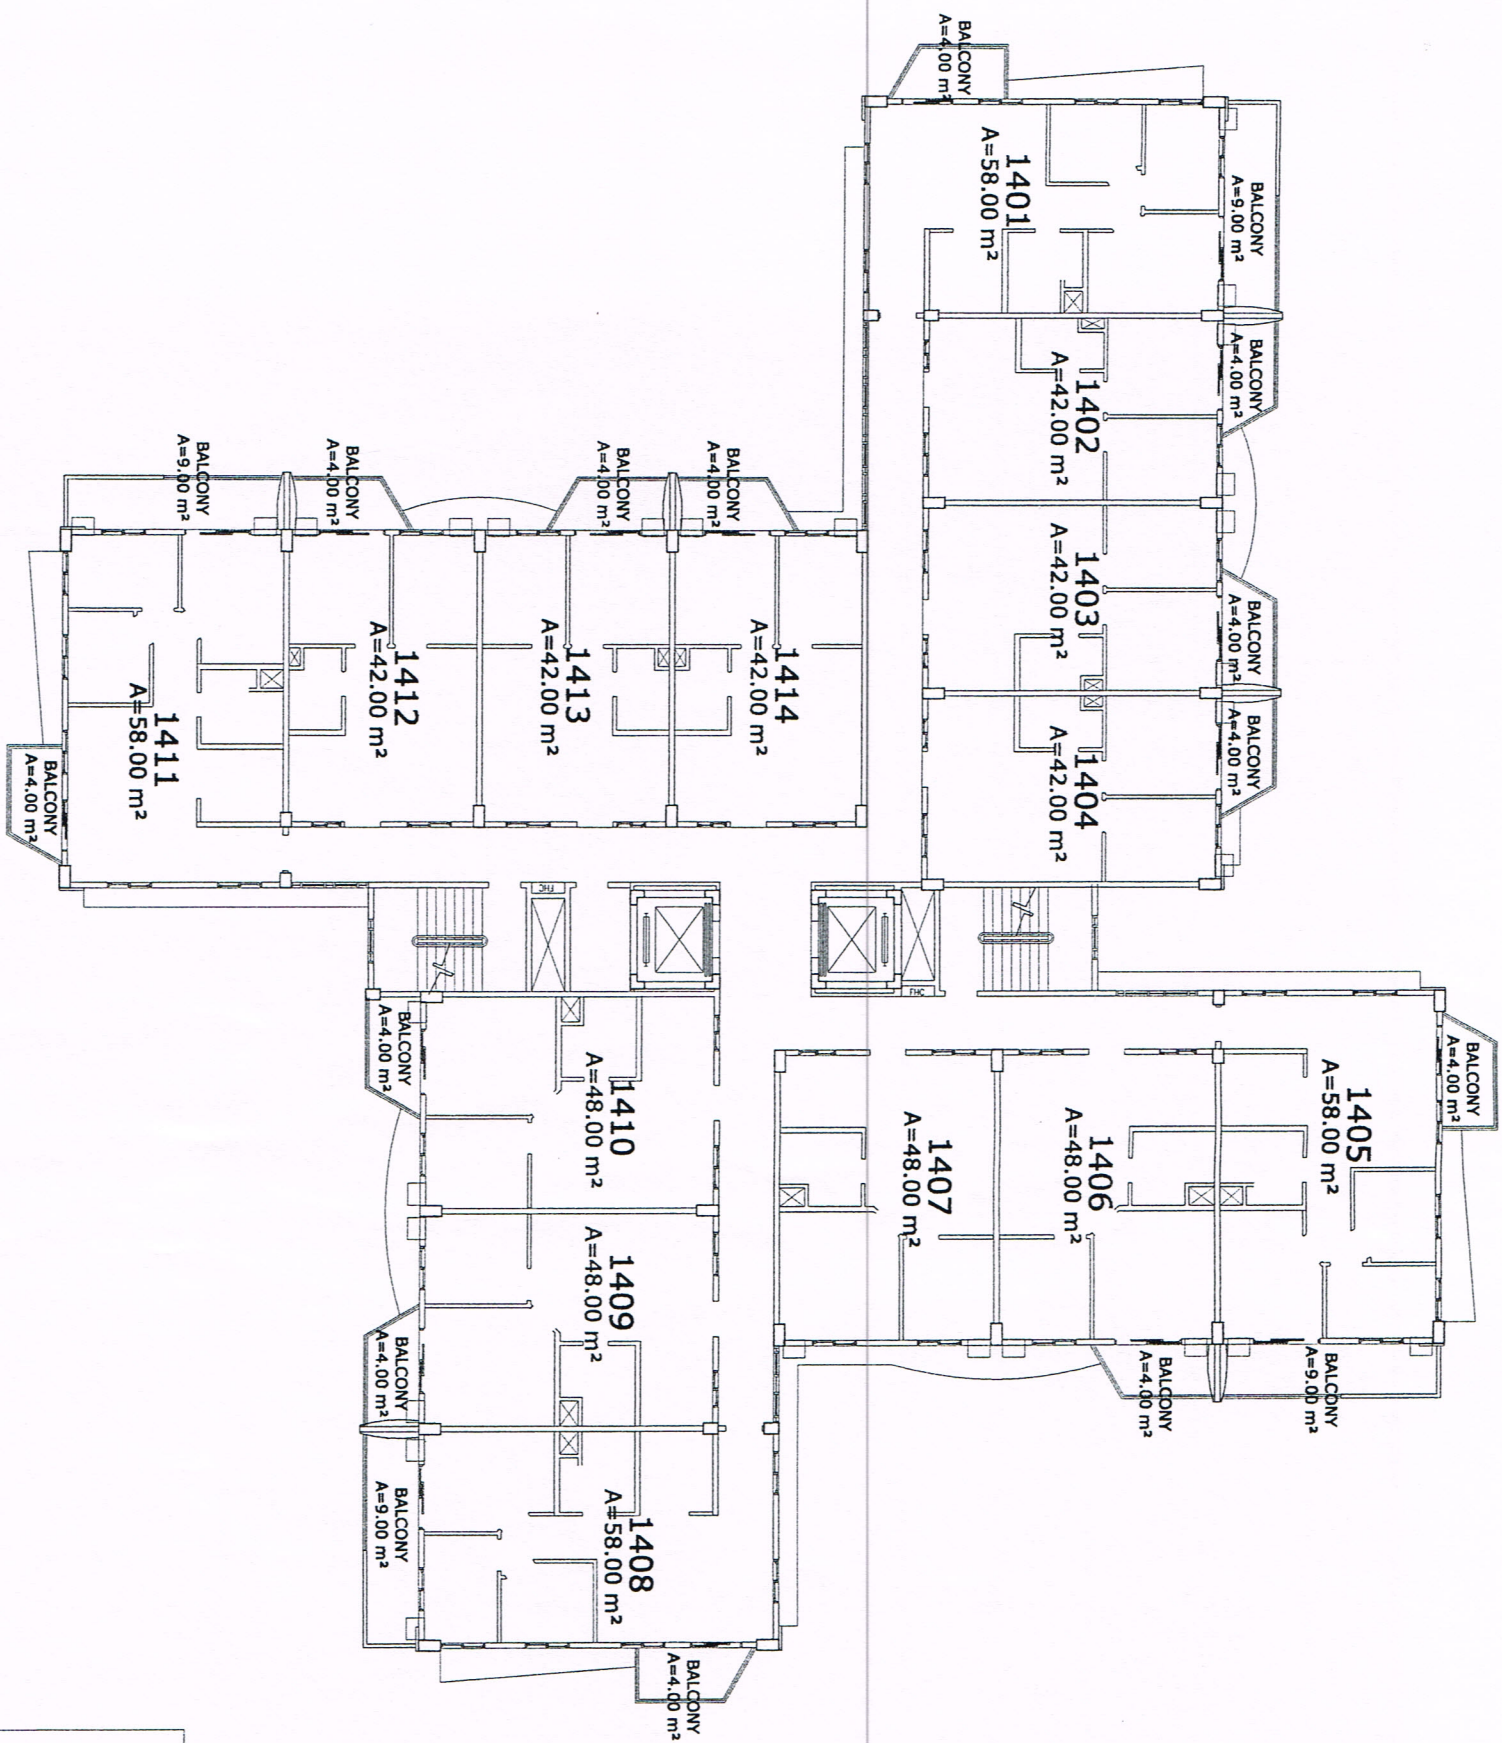


**CYPRESS TOWERS
TOWER B**

14TH FLOOR PLAN

MARCH 6, 2006

[Handwritten signature]


KEYPLAN

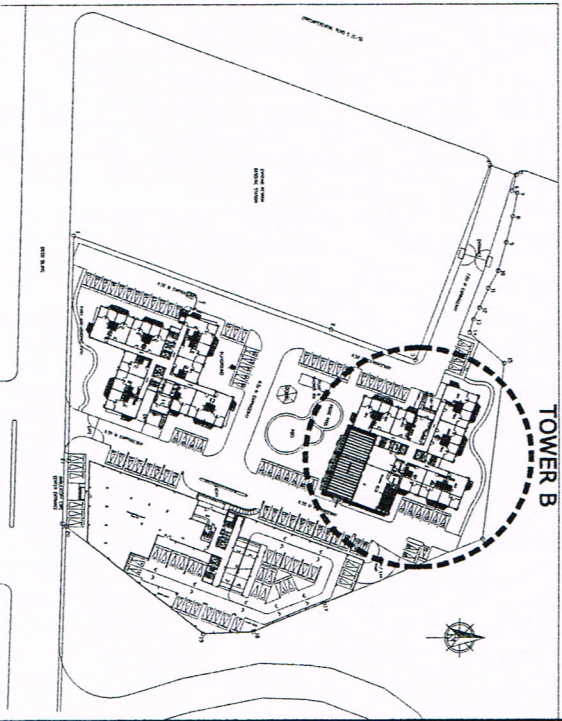

D.M. CONSUNJI, INC.

ENGINEERS • CONTRACTORS

2281 PASONG TAMO EXTENSION, MAKATI CITY
TEL. NO.: 841-0841

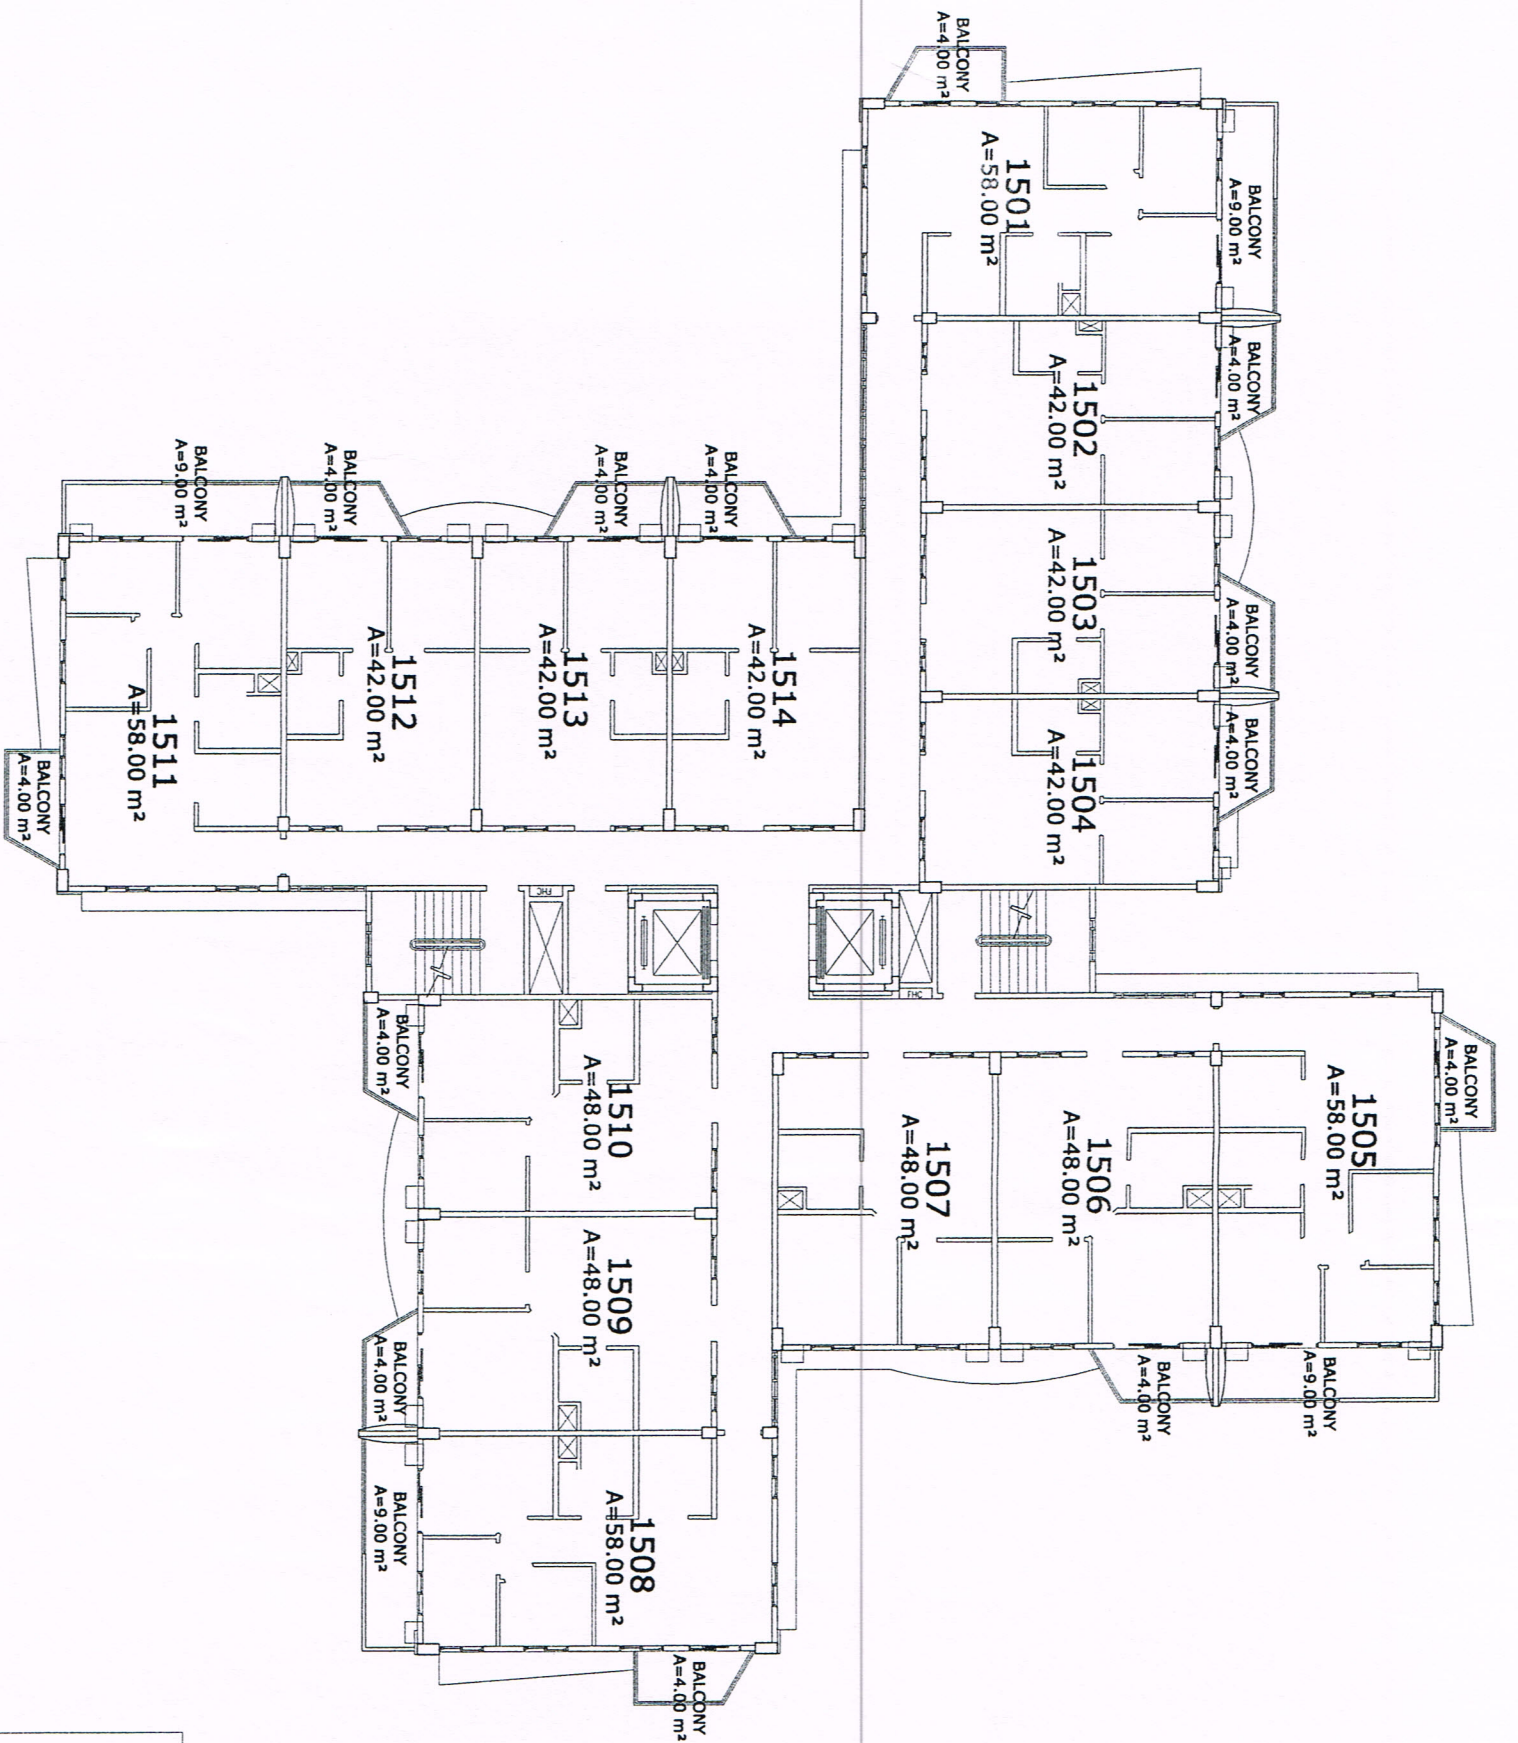



**CYPRESS TOWERS
TOWER B**

15TH FLOOR PLAN

MARCH 6, 2006

Handwritten signature

KEYPLAN

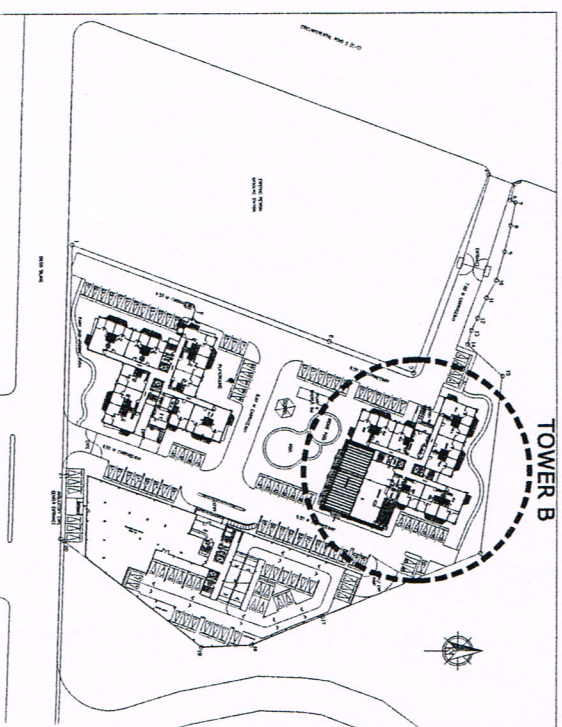


D.M. CONSUNJI, INC.
ENGINEERS • CONTRACTORS

2281 PASONG TAMO EXTENSION, MAKATI CITY
TEL. NO.: 841-0841



D.M. CONSUNJI, INC.
ENGINEERS • CONTRACTORS
2281 PASONG TAMO EXTENSION, MAKATI CITY
TEL. NO.: 841-0841

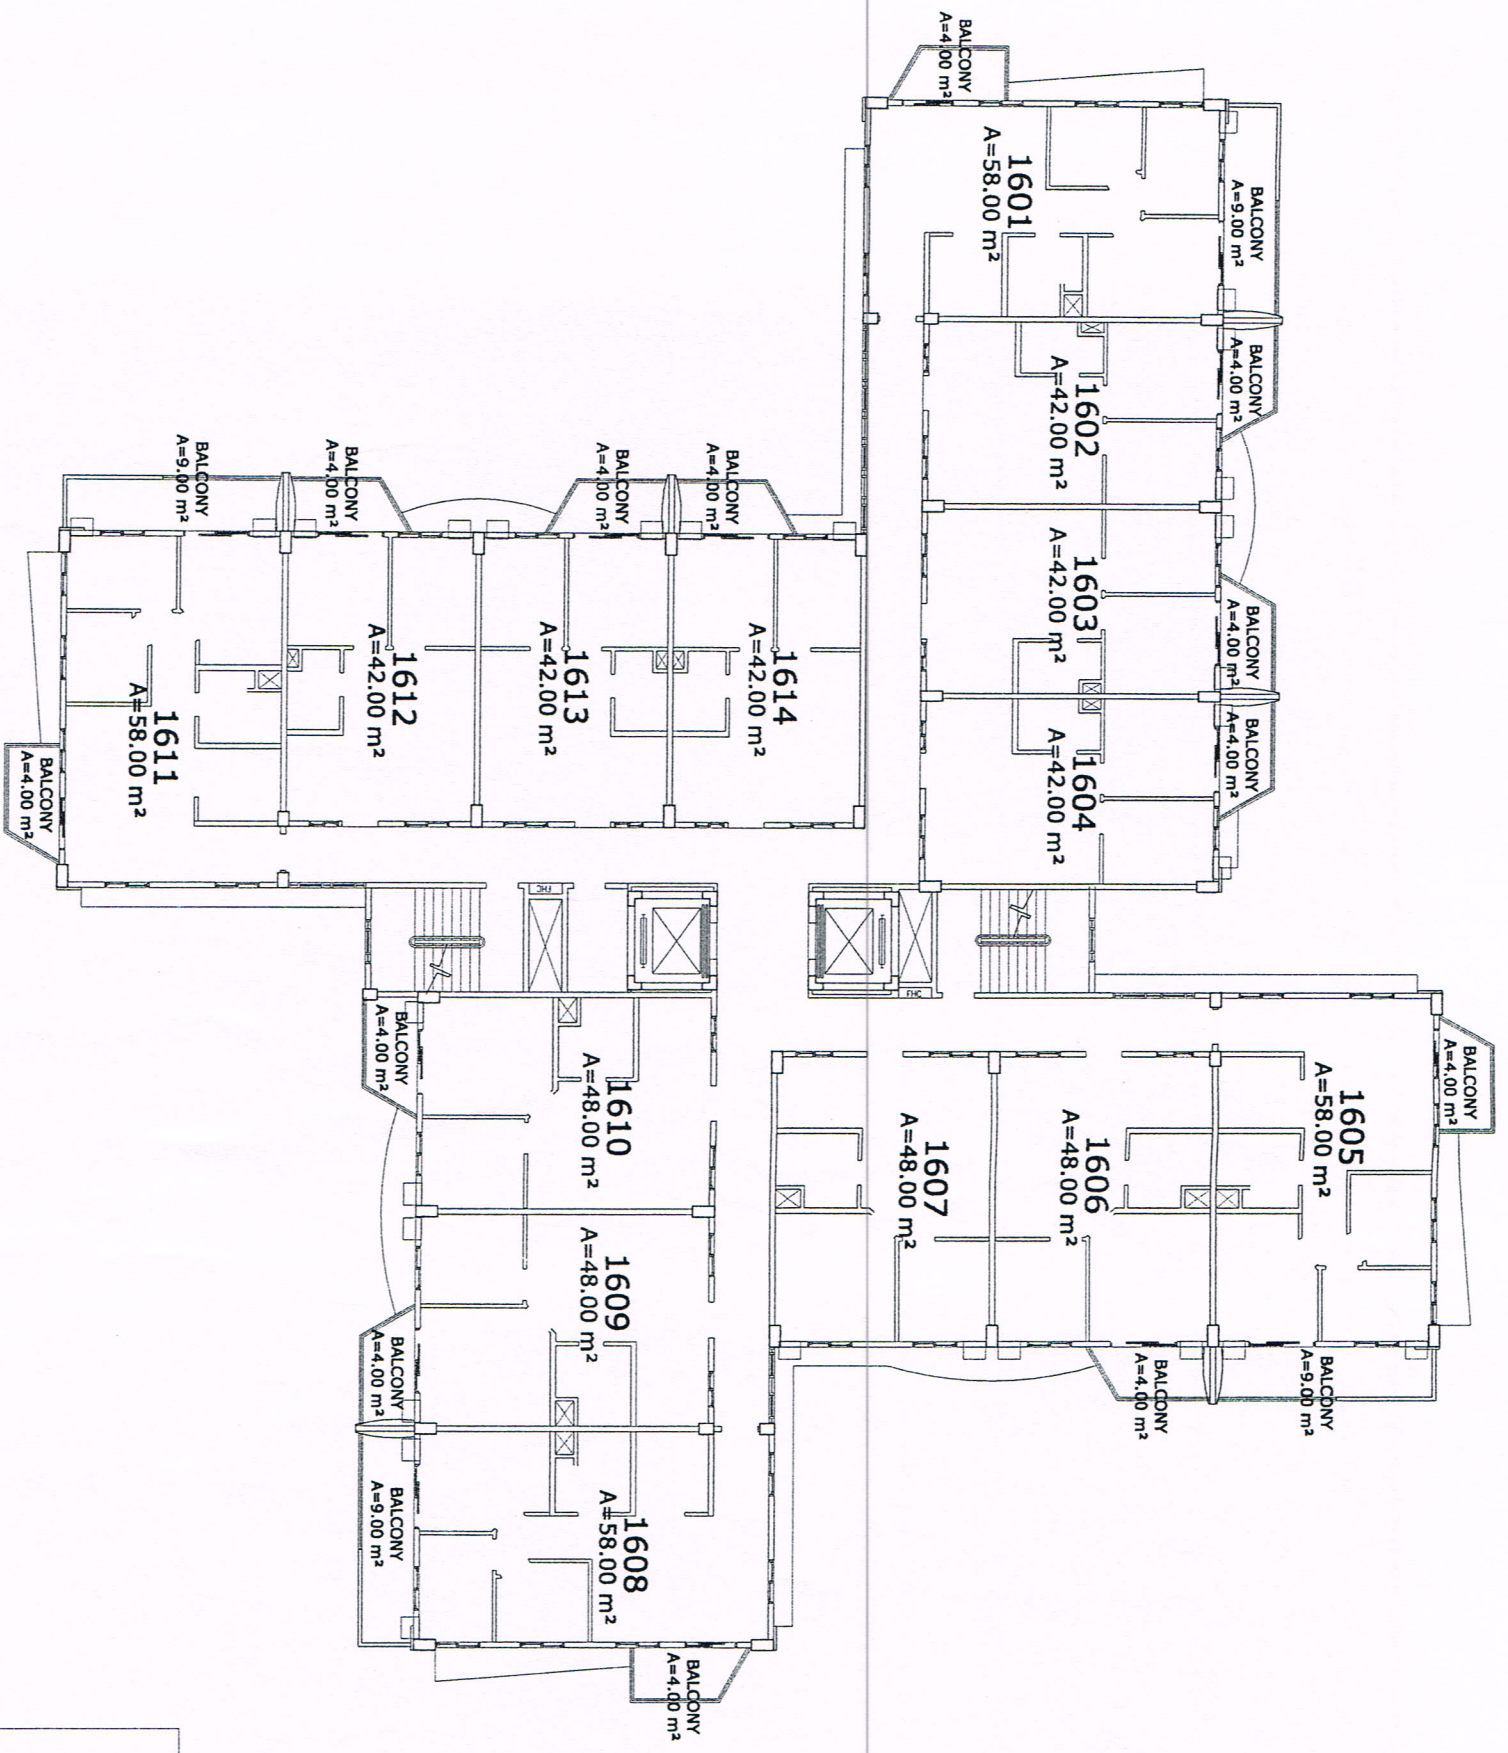


**CYPRESS TOWERS
TOWER B**


16TH FLOOR PLAN

MARCH 6, 2006

gibson

KEYPLAN

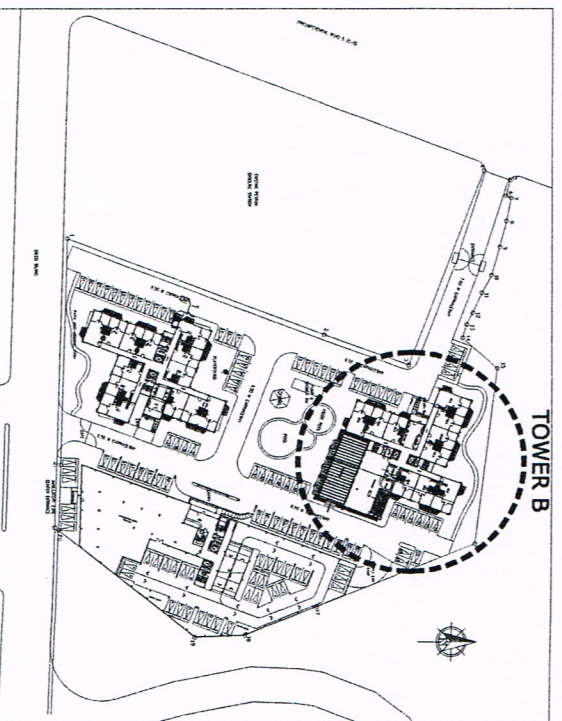

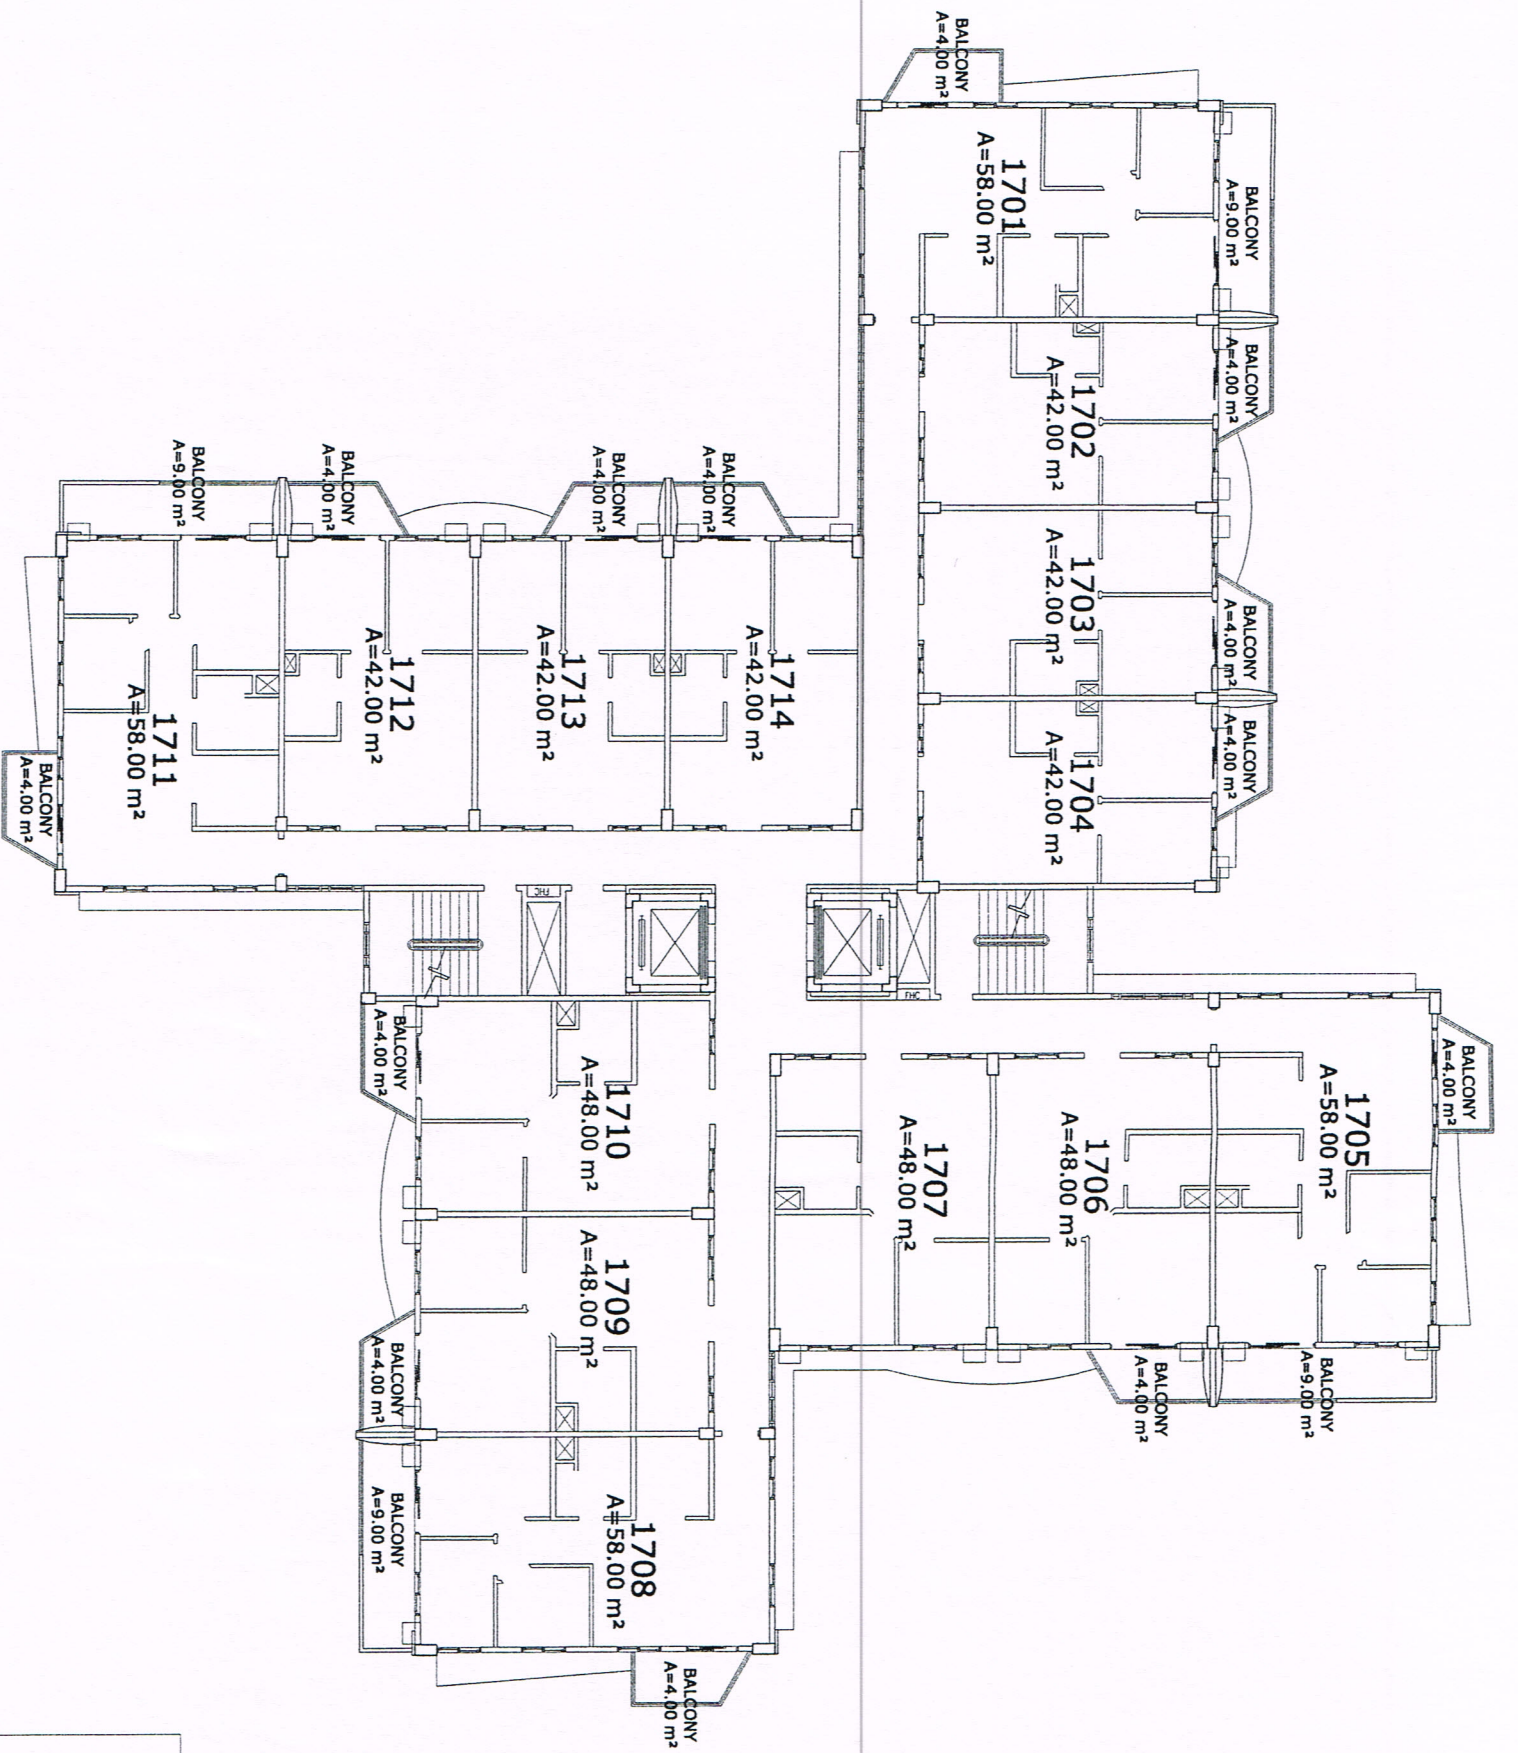



**CYPRESS TOWERS
 TOWER B**

17TH FLOOR PLAN

MARCH 6, 2006

Handwritten signature

KEYPLAN

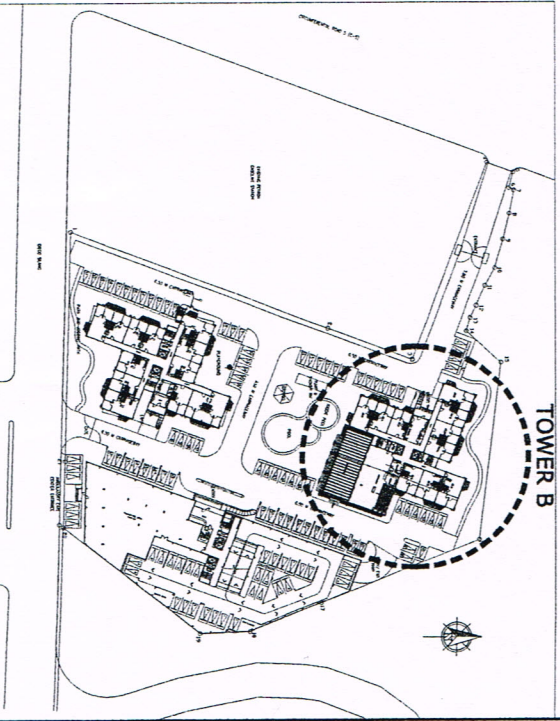

D.M. CONSUNJI, INC.

ENGINEERS • CONTRACTORS


2281 PASONG TAMO EXTENSION, MAKATI CITY
 TEL. NO.: 841-0841



D.M. CONSUNJI, INC.

ENGINEERS · CONTRACTORS

2281 PASONG TAMO EXTENSION, MAKATI CITY
TEL. NO.: 841-0841

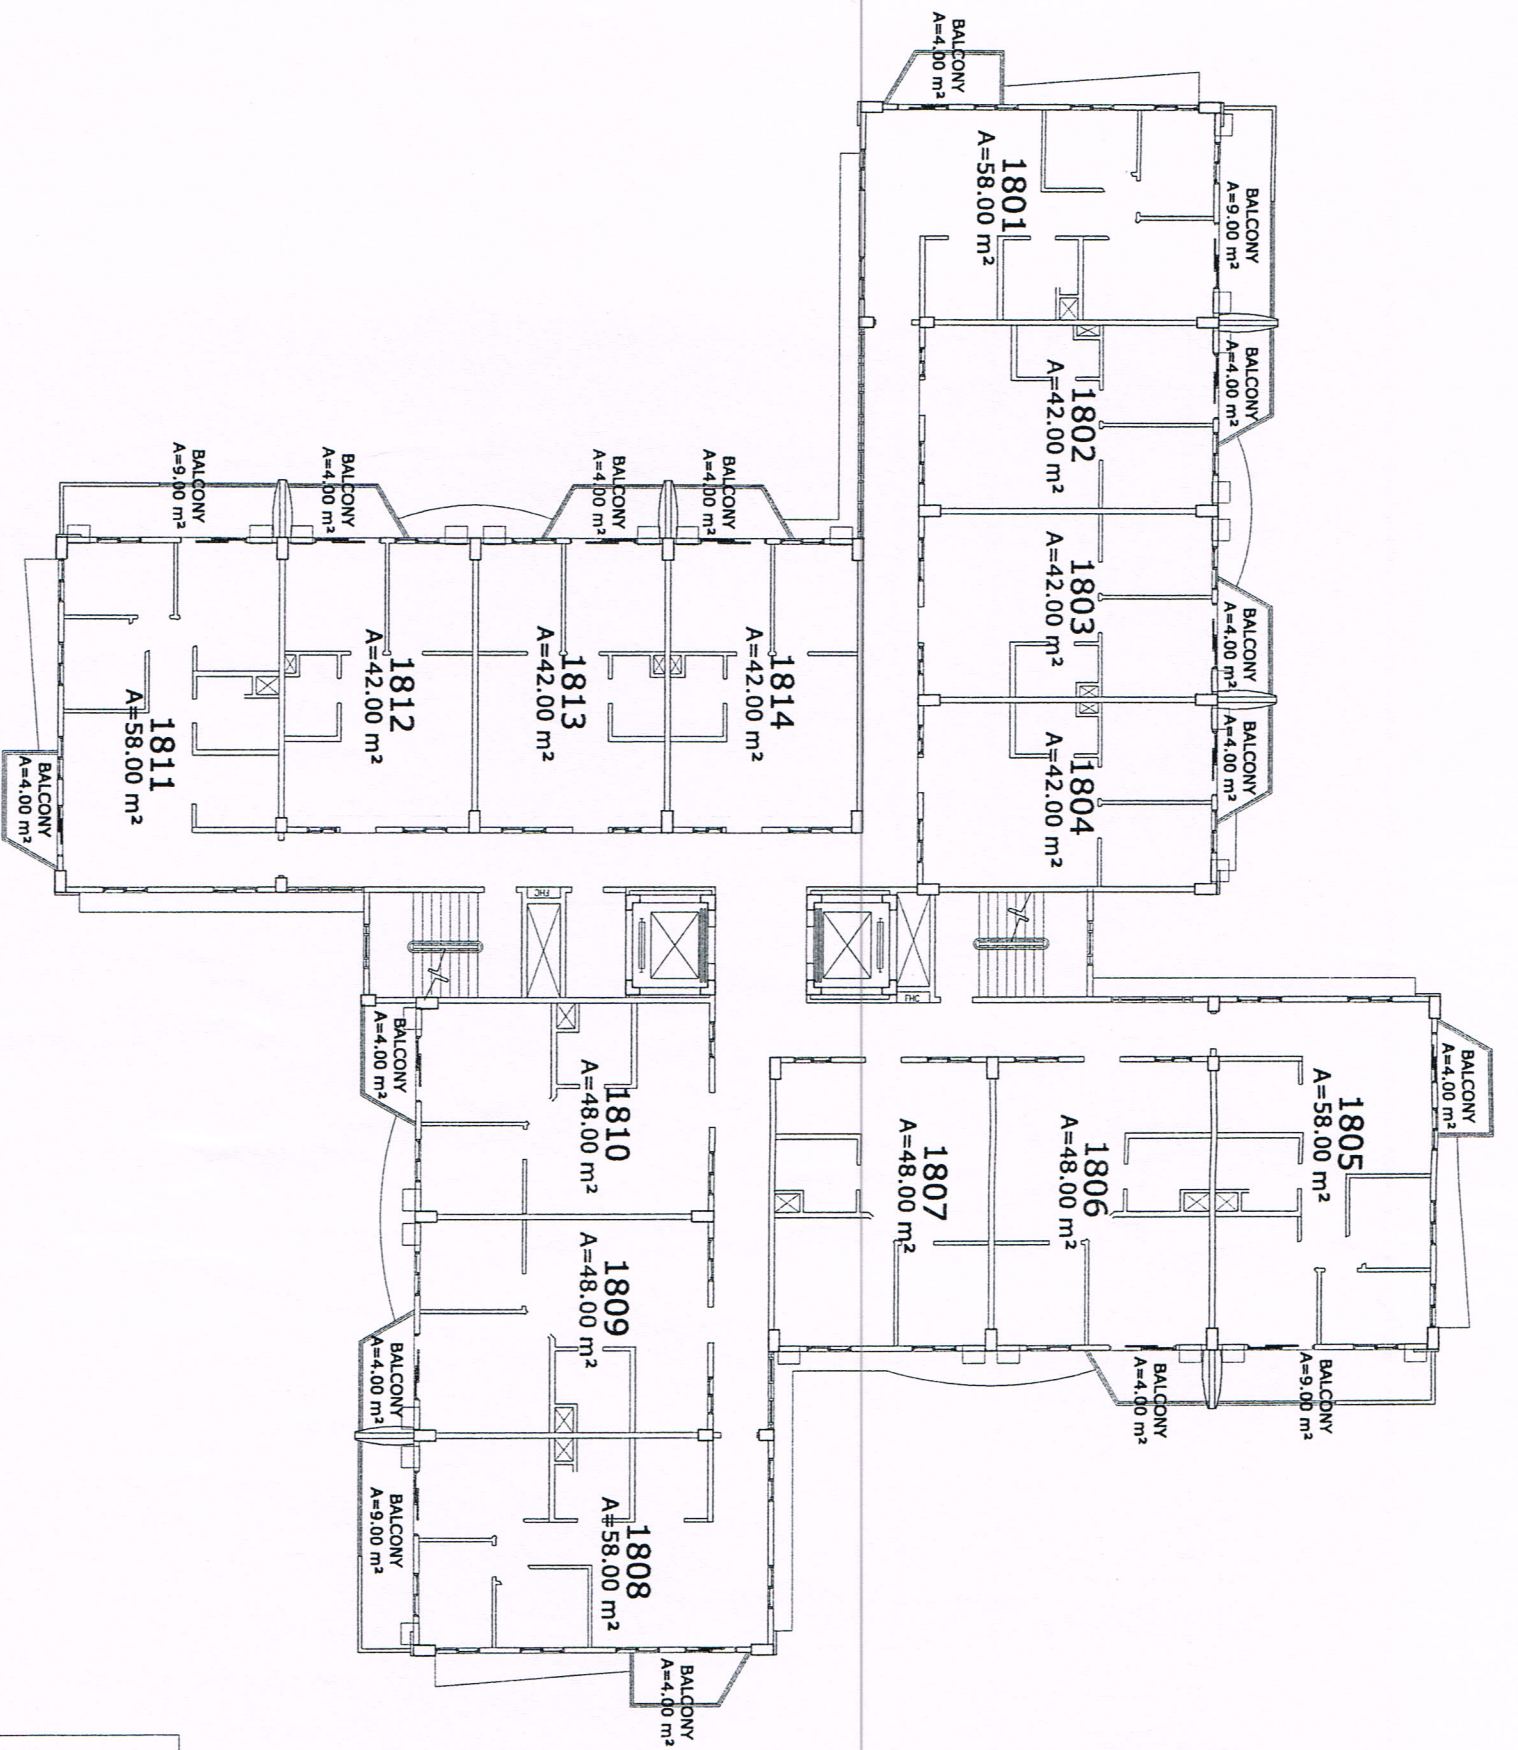


**CYPRESS TOWERS
TOWER B**

18TH FLOOR PLAN

MARCH 6, 2006

Handwritten signature

KEYPLAN

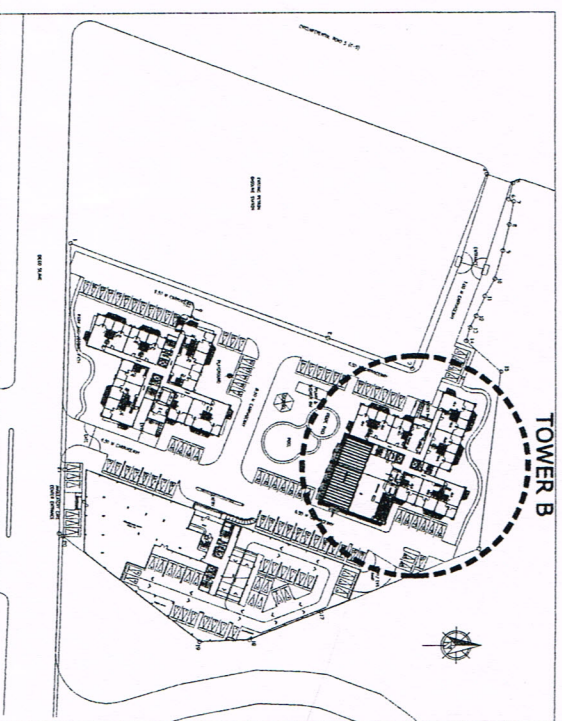



D.M. CONSUNJI, INC.

ENGINEERS · CONTRACTORS


2281 PASONG TAMO EXTENSION, MAKATI CITY
TEL. NO.: 841-0841

CYPRESS TOWERS TOWER B


19TH FLOOR PLAN

DECEMBER 20, 2006


Signature

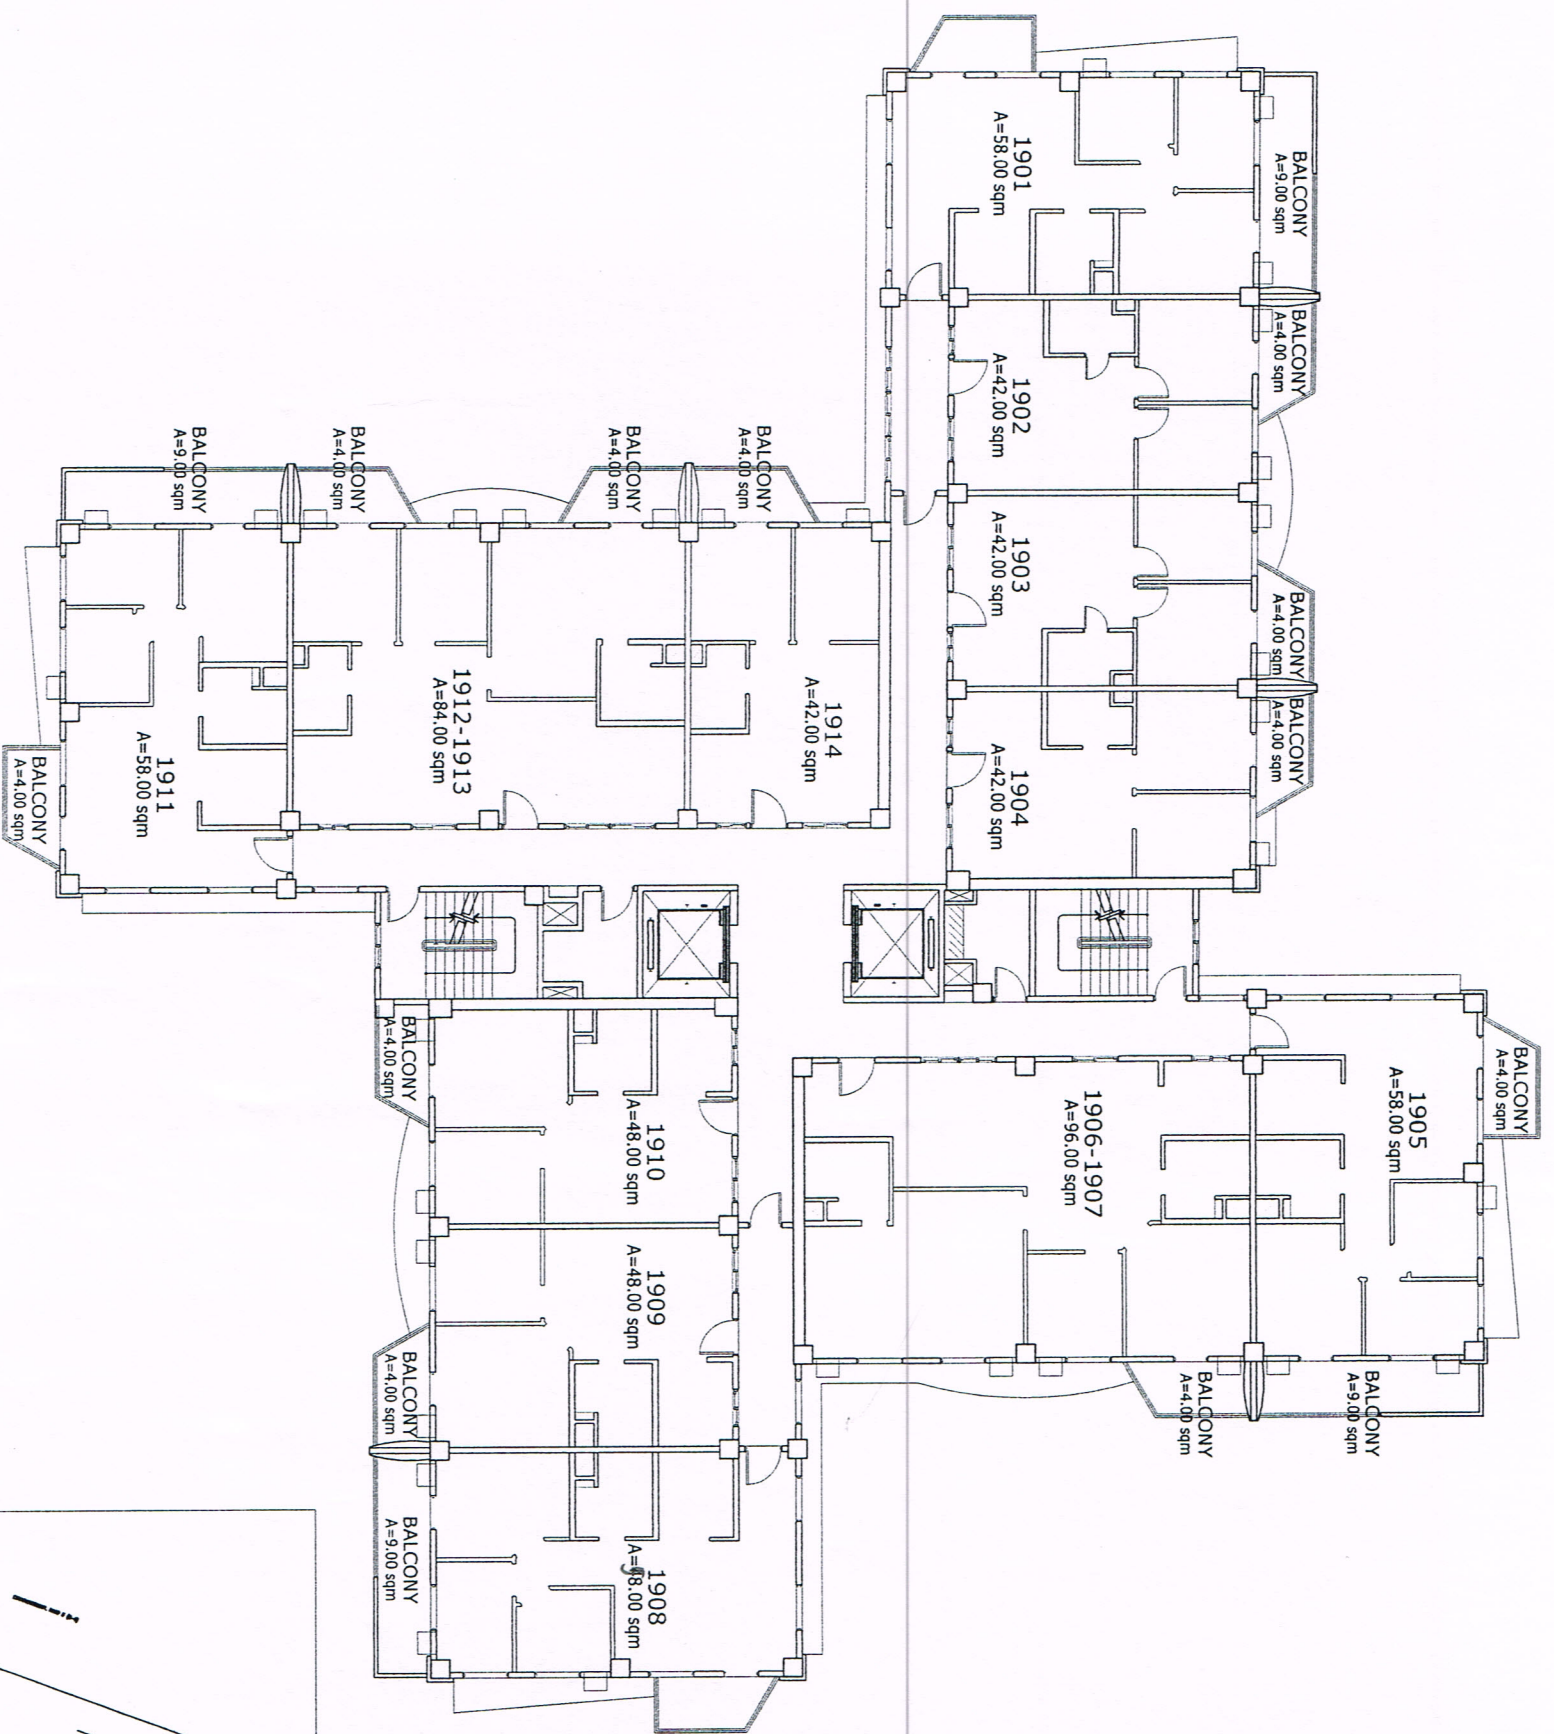

KEYPLAN

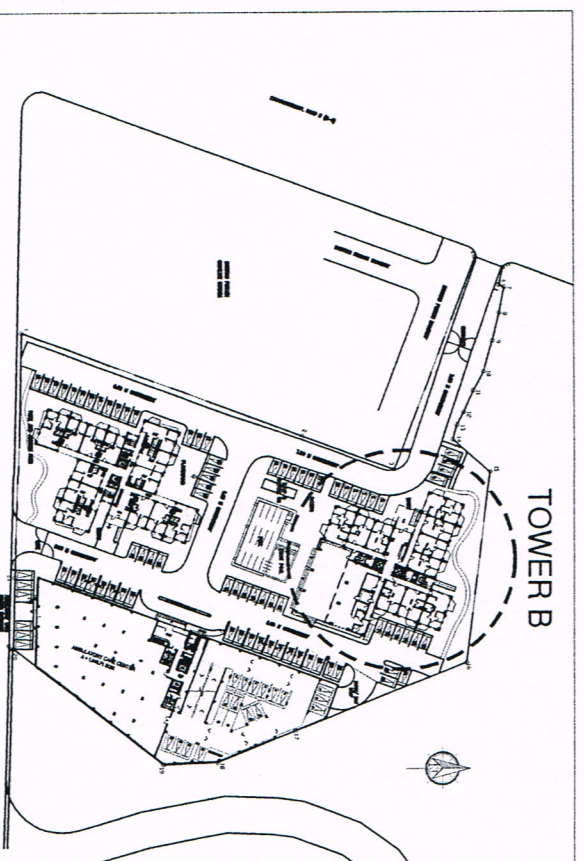

FOR REFERENCE
DATE: 27 JAN 2009

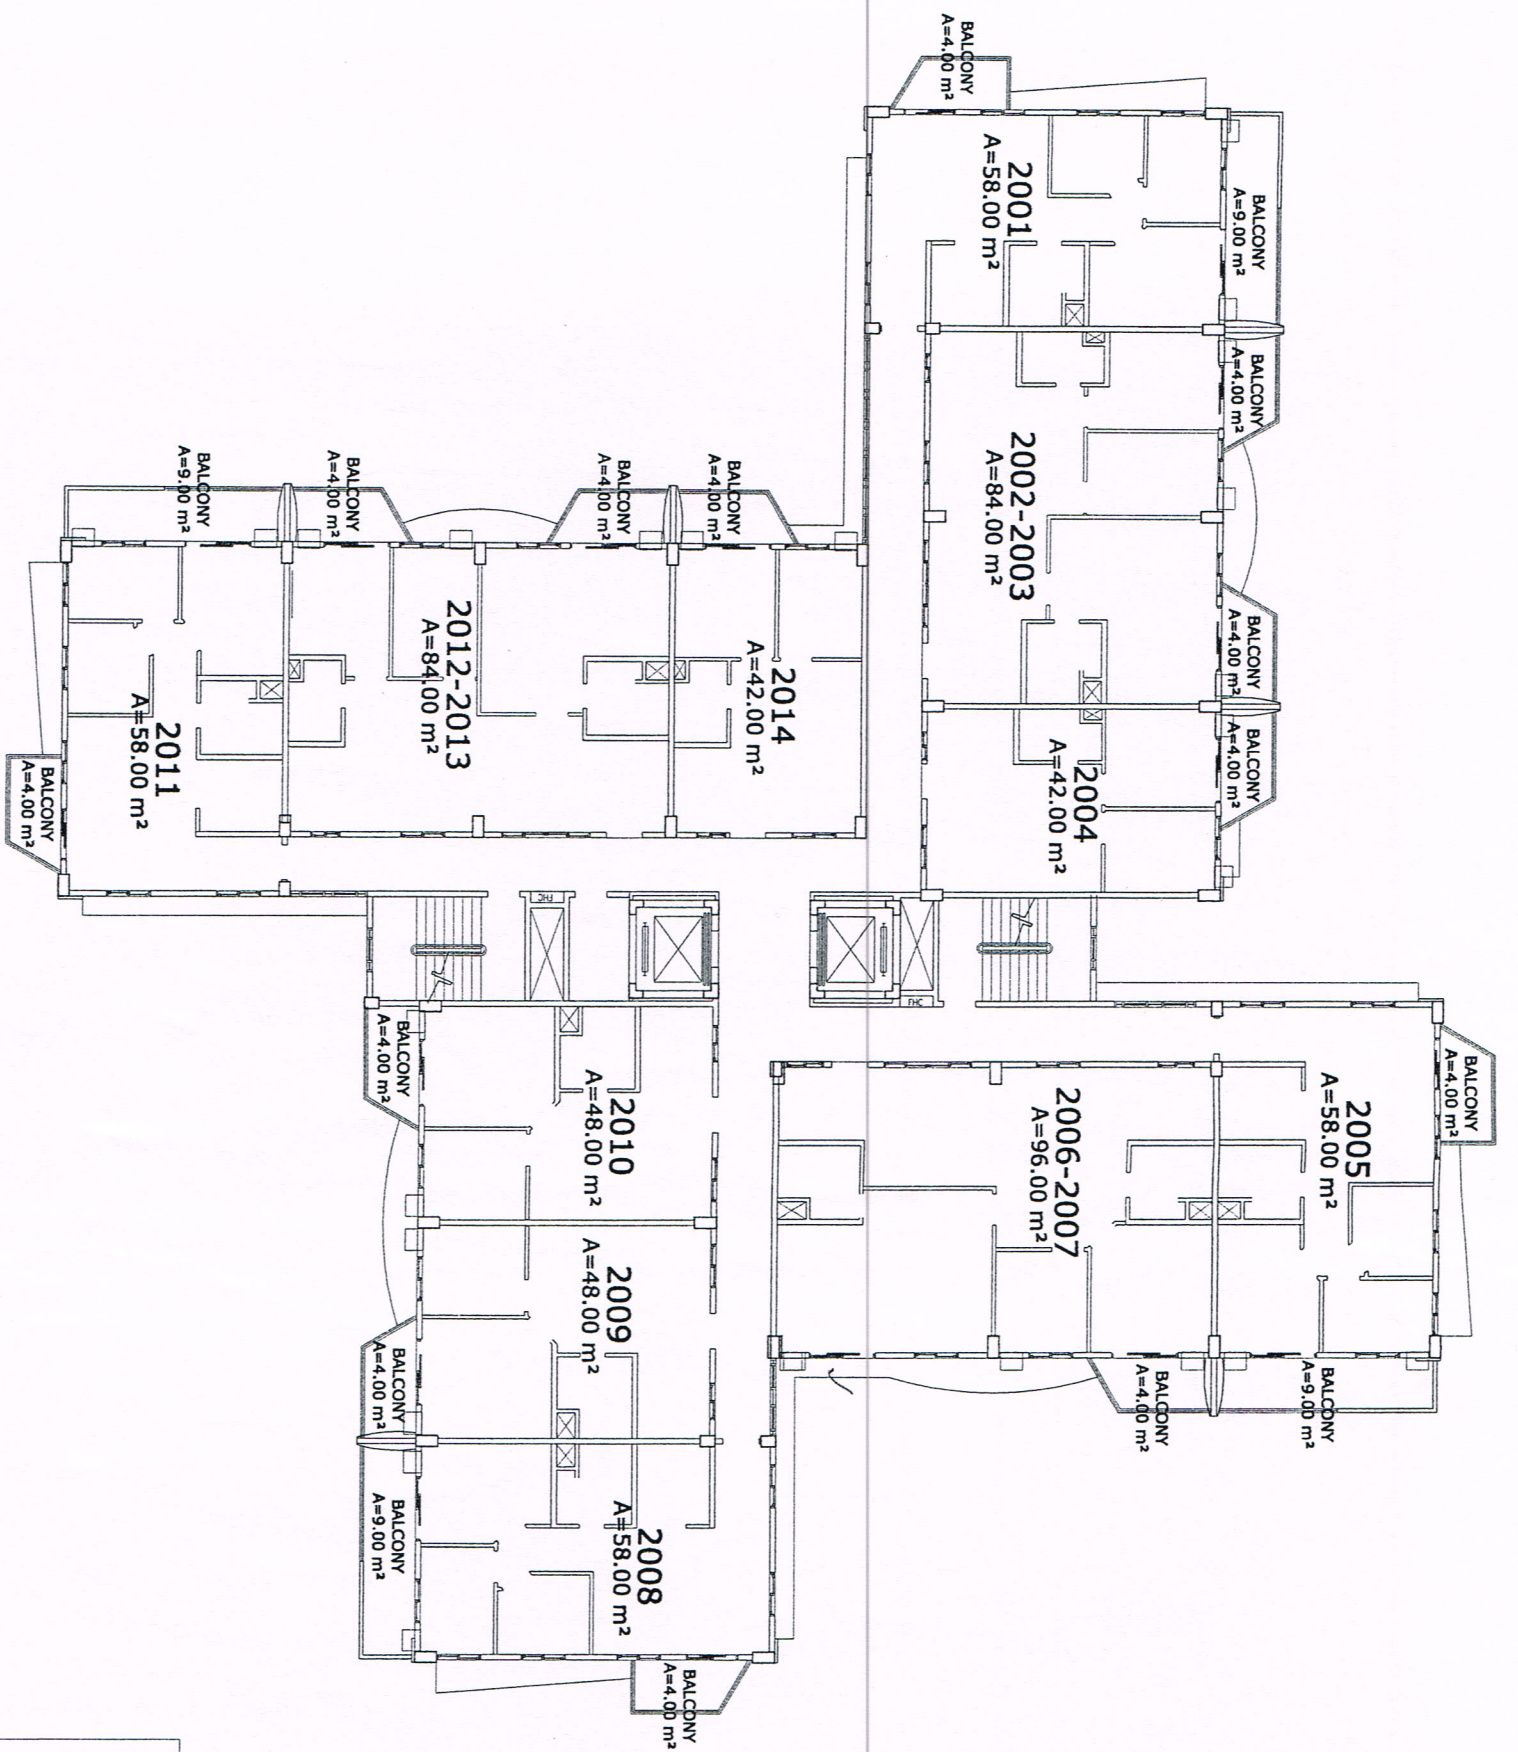


**CYPRESS TOWERS
TOWER B**

20TH FLOOR PLAN

MARCH 6, 2006


gibson

KEYPLAN

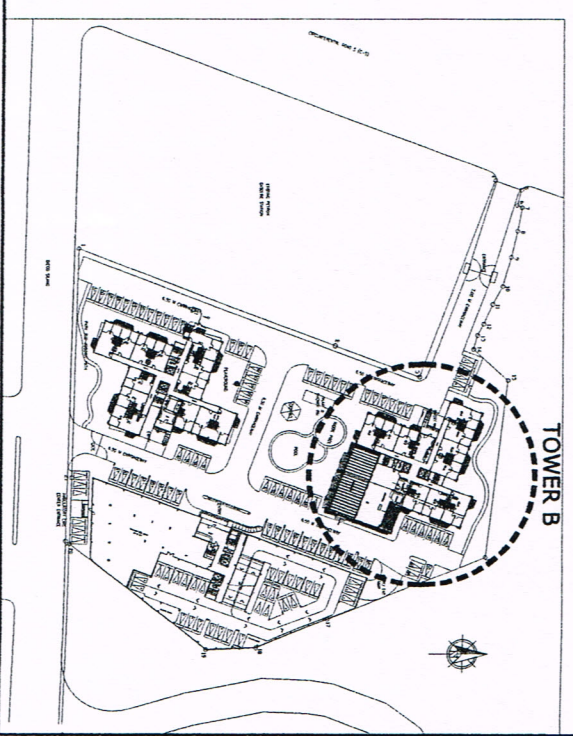

D.M. CONSUNJI, INC.
ENGINEERS • CONTRACTORS
2281 PASONG TAMO EXTENSION, MAKATI CITY
TEL. NO.: 841-0641



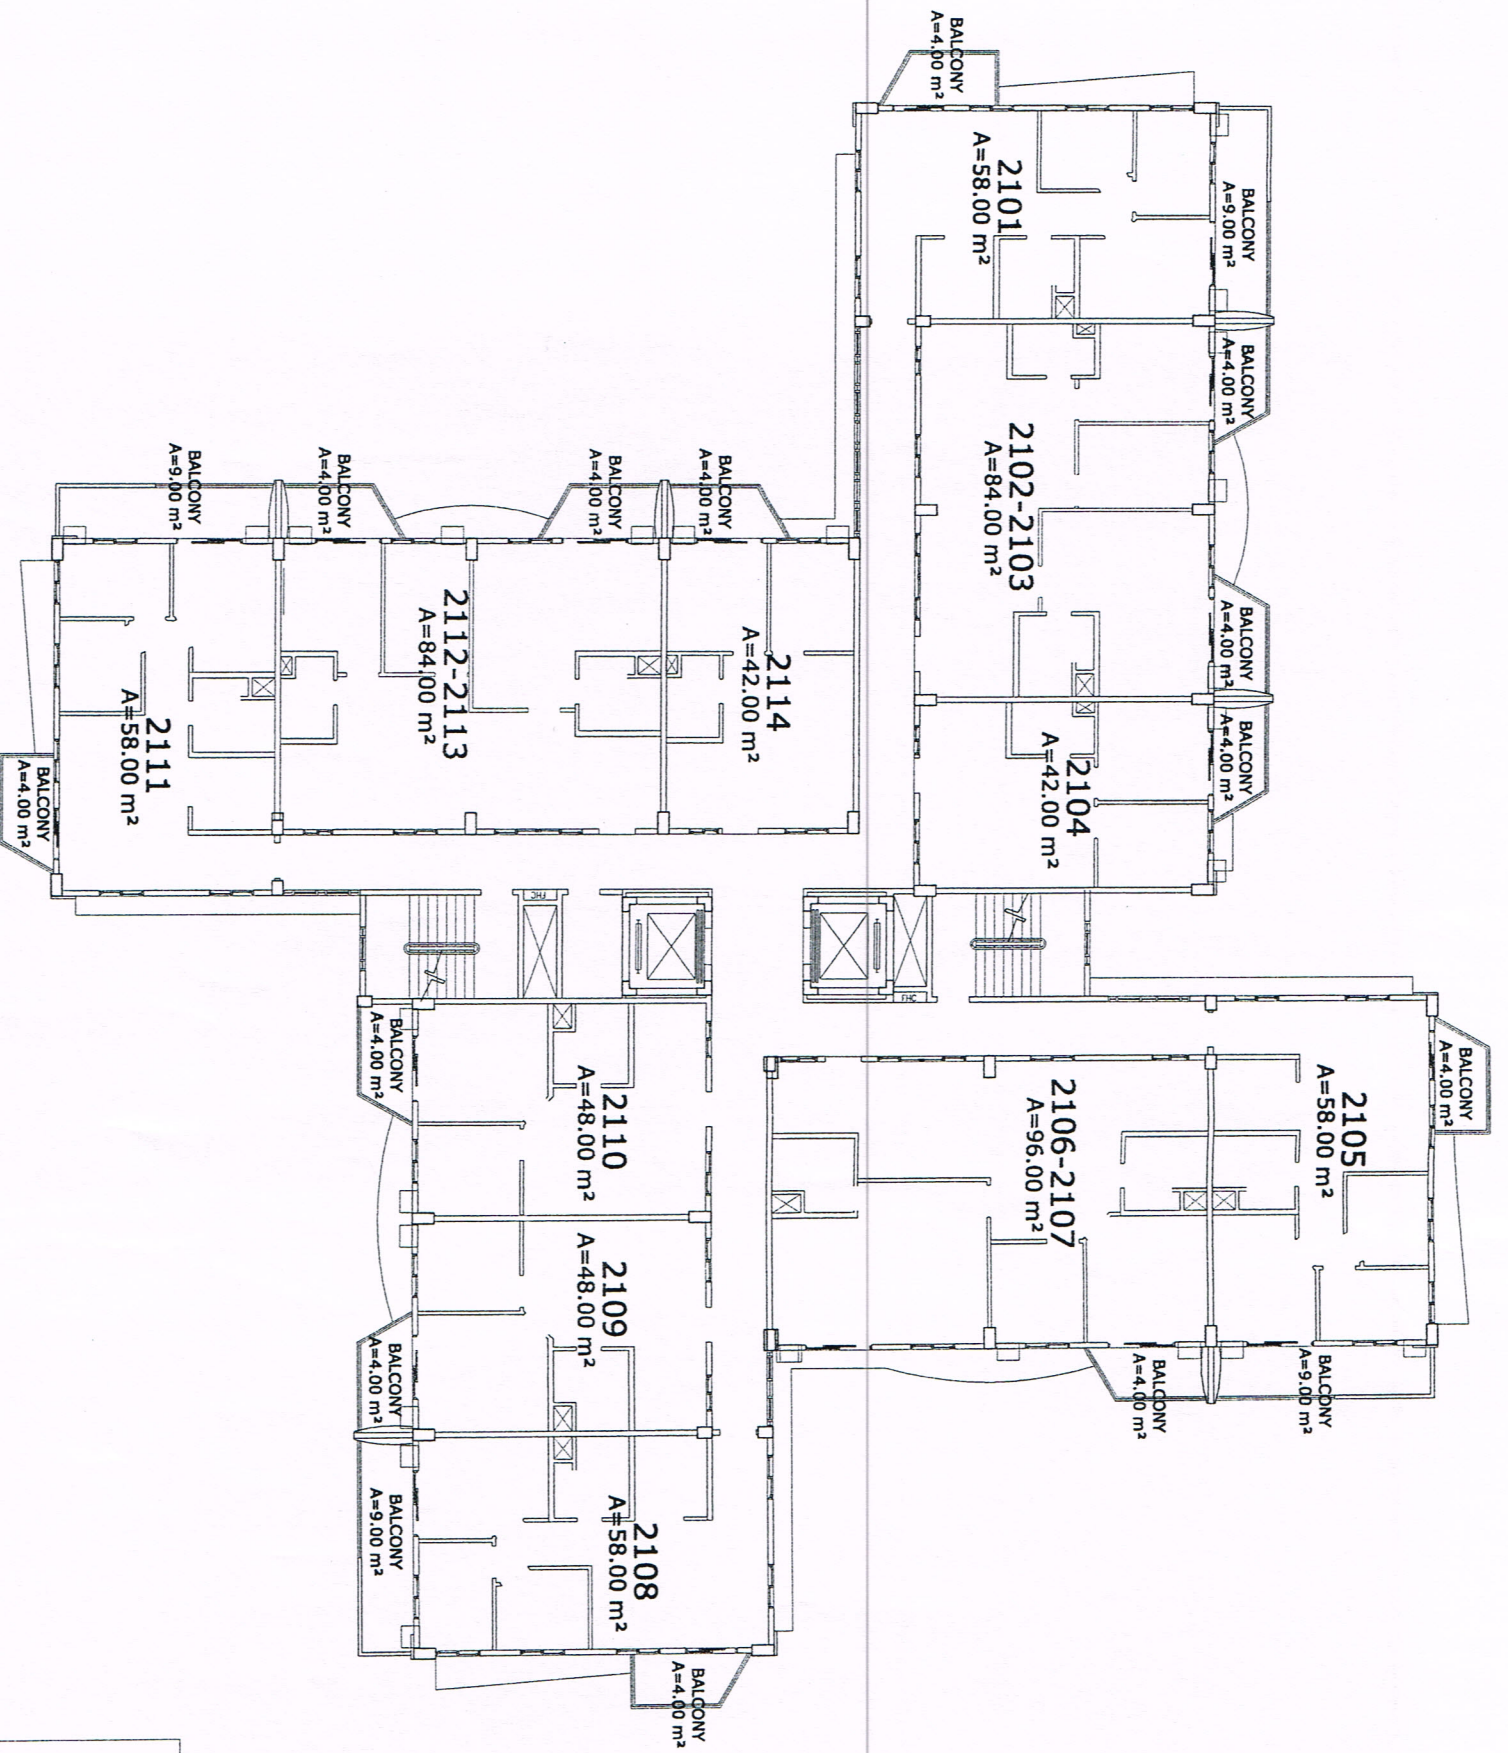



**CYPRESS TOWERS
TOWER B**

21TH FLOOR PLAN

MARCH 6, 2006

*all
done*


KEYPLAN

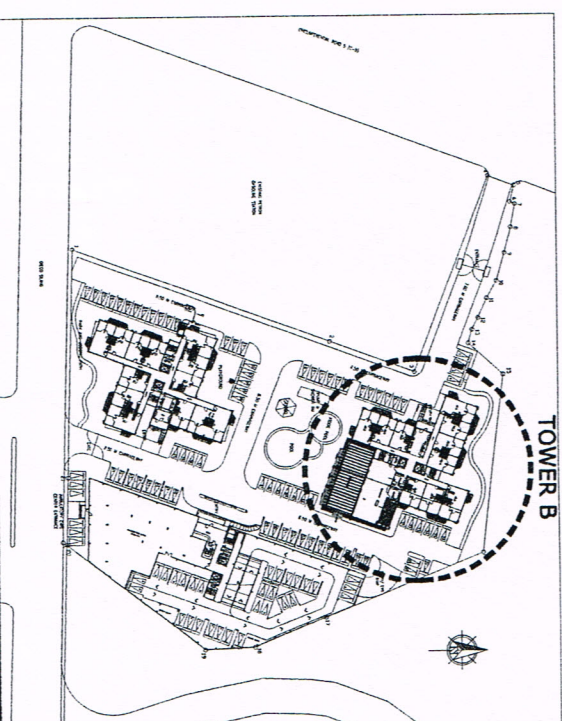

D.M. CONSUNJI, INC.

ENGINEERS · CONTRACTORS

2281 PASONG TAMO EXTENSION, MAKATI CITY
TEL. NO.: 841-0841

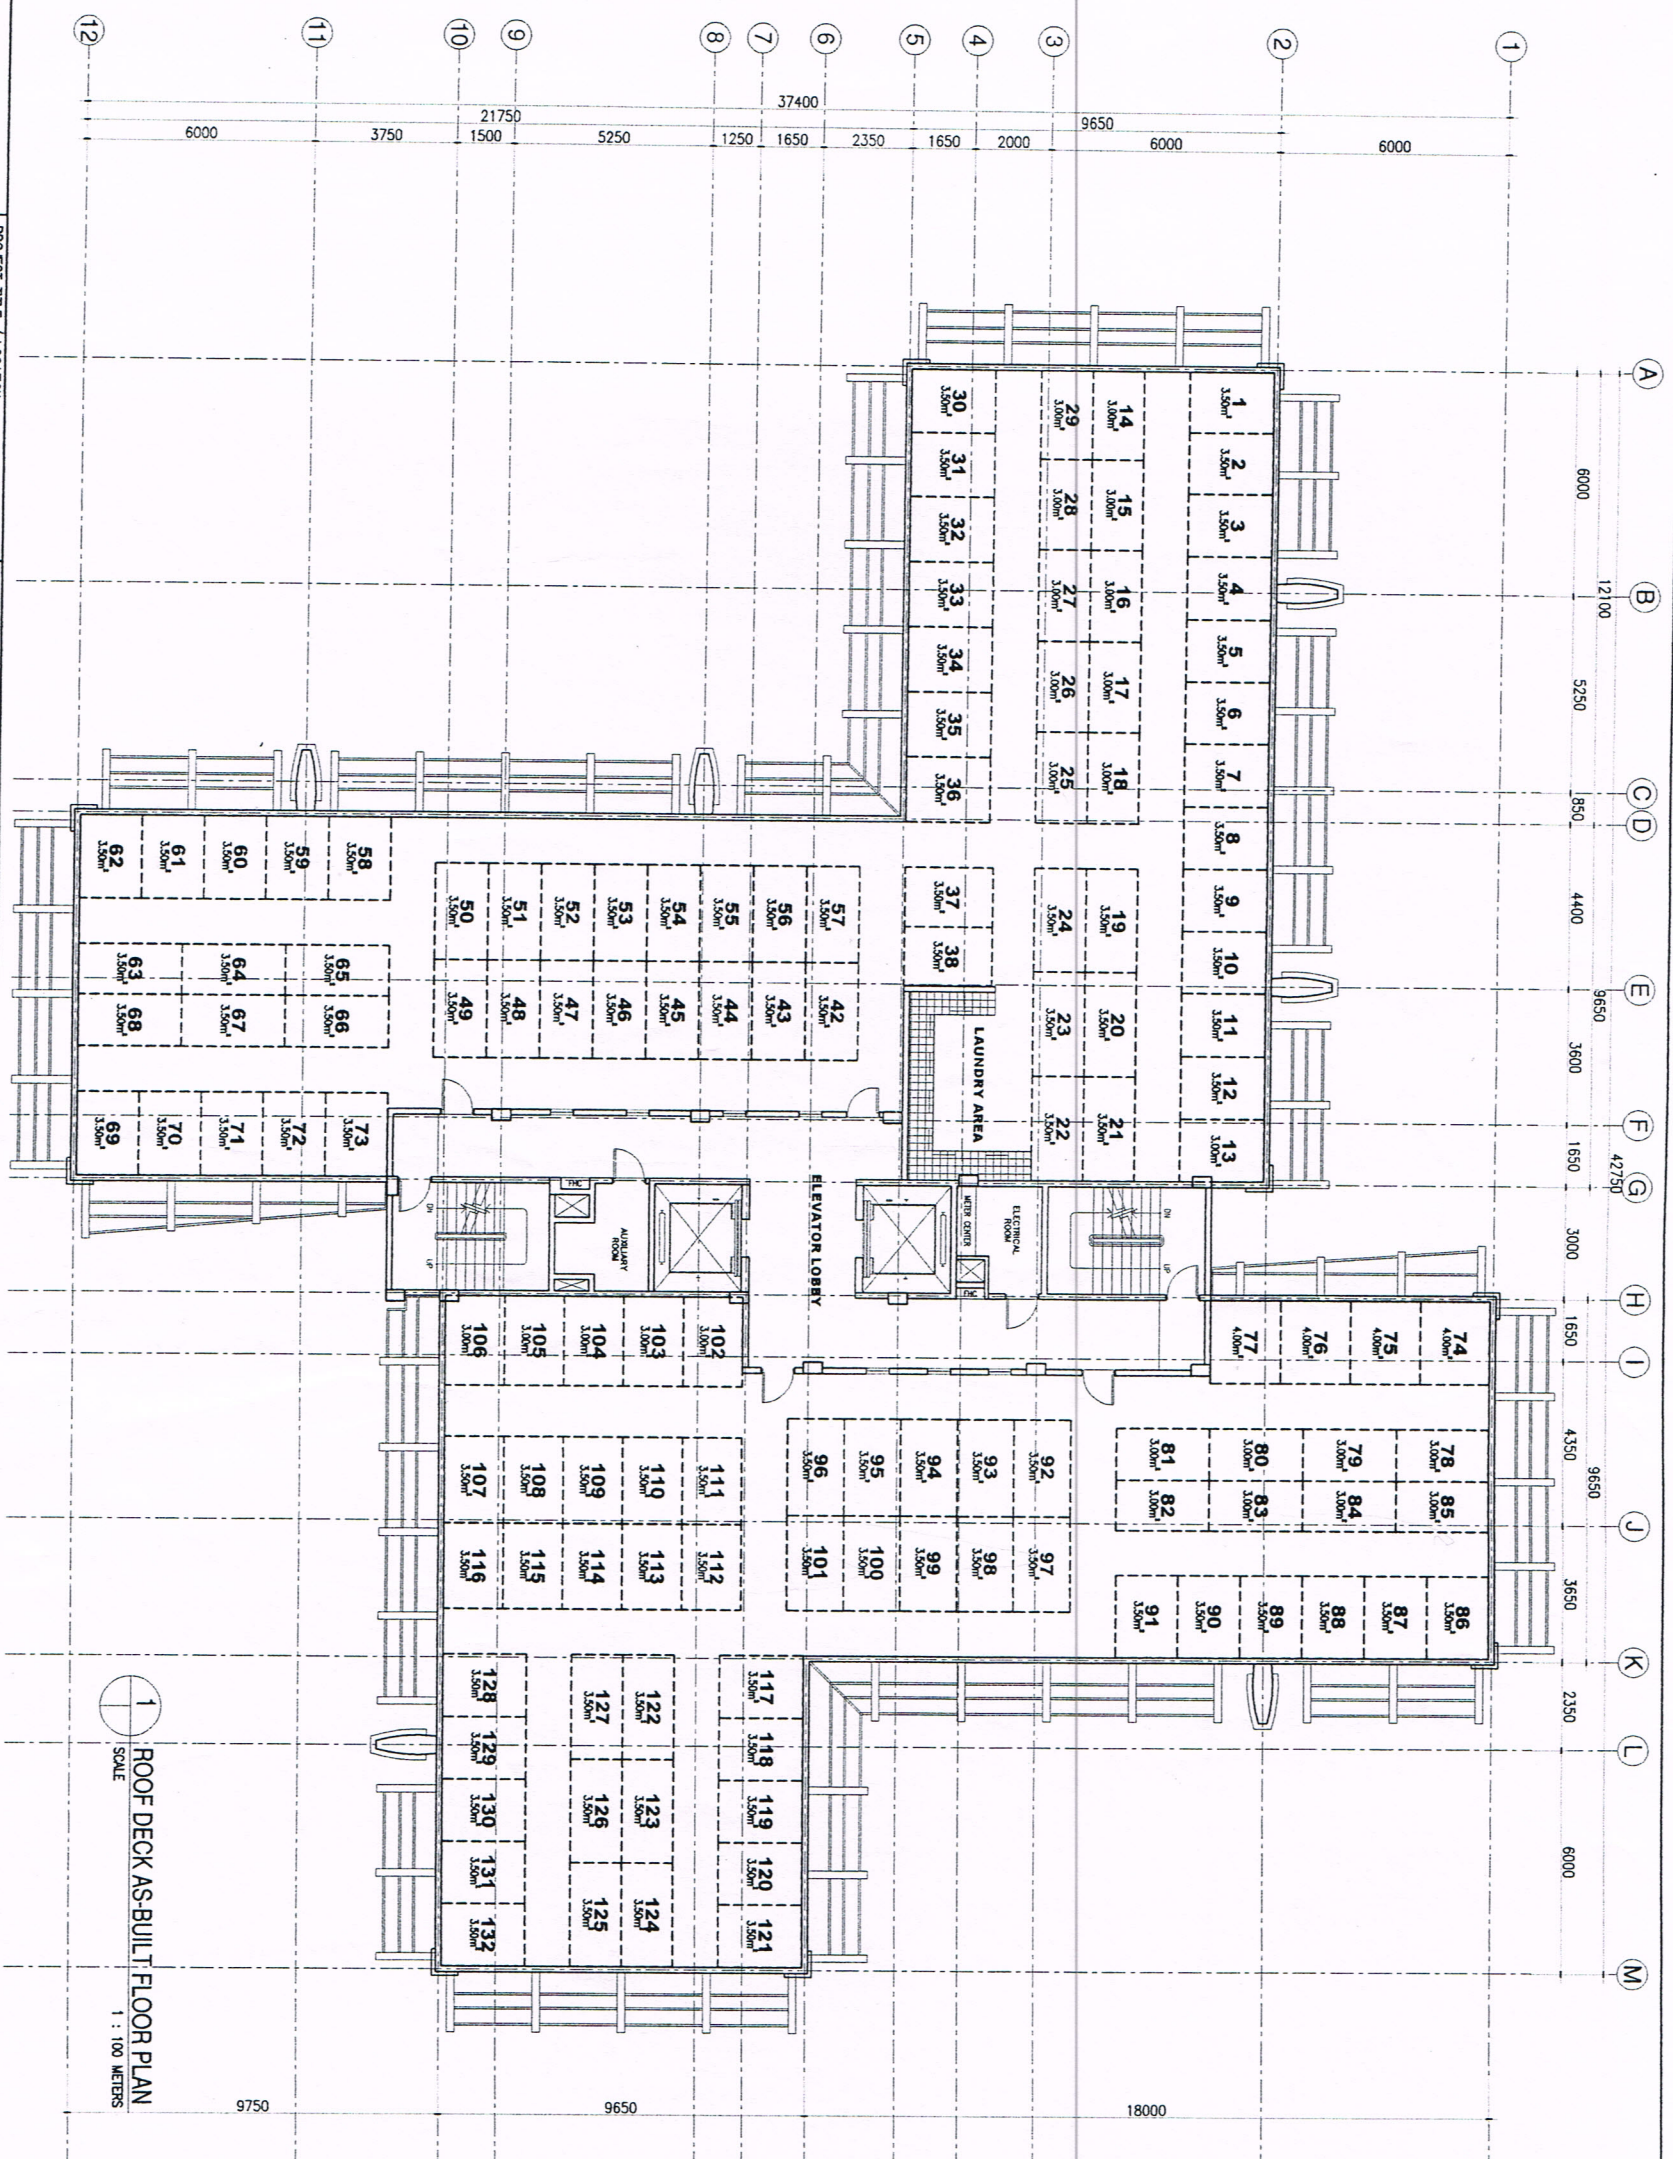

1 ROOF DECK AS-BUILT FLOOR PLAN
SCALE
1 : 100 METERS

PREPARED BY:
D.M. CONSUNJII, INC.
ENGINEERS - CONTRACTORS
2281 PASONG TAJAO EXTENSION, MAKATI CITY
TEL. NO.: 841-0841

PROJECT TITLE / LOCATION
**CYPRESS TOWERS
TOWER B**

ARCHITECT
MA. SEVERINA M. SORIANO

ENGINEER
DATE: 04 JAN 2008
REG. NO.: 7854

OWNER
**CROWN EQUITIES, INC./
FORT BONIFACIO MEDICAL CENTER, INC.**

DEVELOPER
DMCI - PDI

SHEET CONTENTS
ROOF DECK AS-BUILT FLOOR PLAN

NO. DATE REVISIONS

DRAWN BY: mobilizer APPROVED BY: HWA
DATE: 2009 01 23 DATE: 2009 01 23


NOTED BY:

HVM	
RMS	<i>[Signature]</i>
GSA	<i>[Signature]</i>
EGC	<i>[Signature]</i>

AS-BUILT

26 JAN 2009

This drawing is the property of the Architect and cannot be used for any other project without the written consent of the Architect. Any reproduction or use of this drawing without the written consent of the Architect shall be held by the Architect.

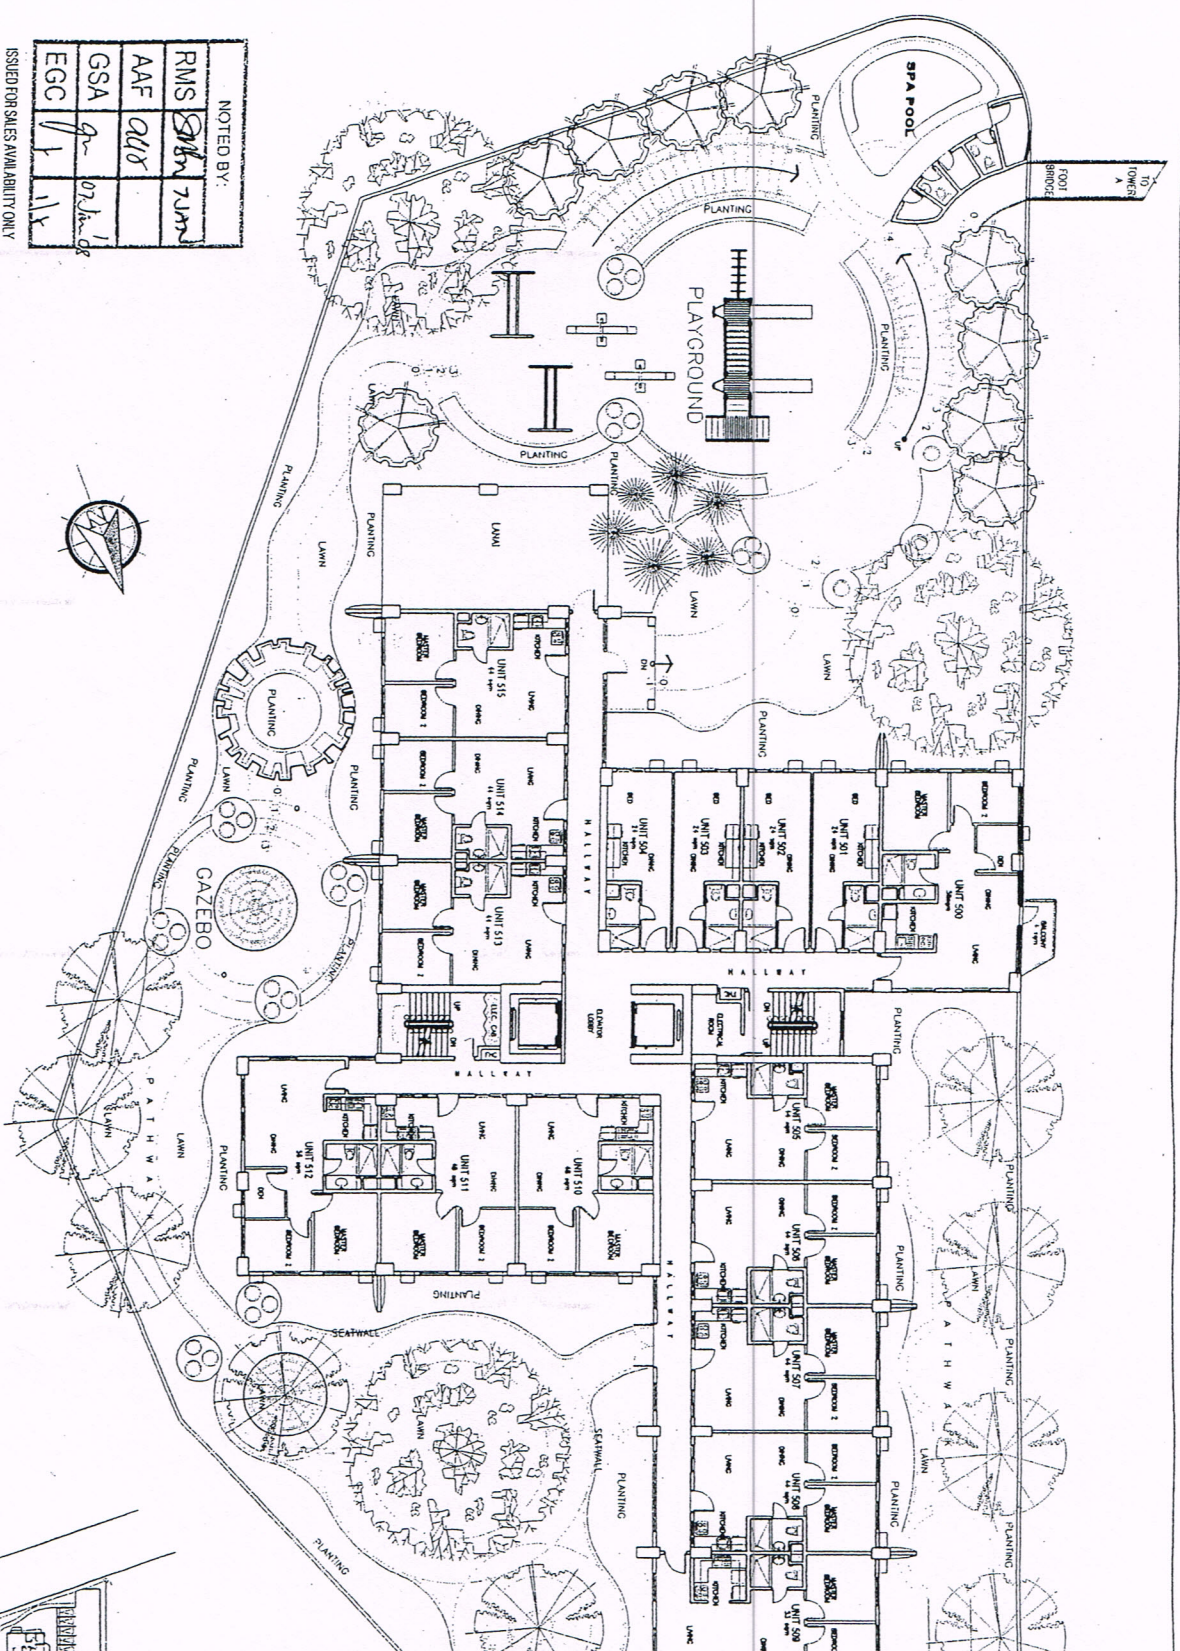

NOTED BY:

RMS	Sabin	7/20/08
AAF	QAR	
GSA	g	07/20/08
EGC	1	11/1

ISSUED FOR SALES AVAILABILITY ONLY

NO.	DATE	REVISIONS
1	07/20/08	ISSUED FOR SALES AVAILABILITY
2	07/20/08	REVISED TO SHOW UNIT 515
3	07/20/08	REVISED TO SHOW UNIT 515
4	07/20/08	REVISED TO SHOW UNIT 515




CYPRESS TOWERS

"TOWER C" (CELESTA)


5TH FLOOR PLAN

16 JUNE 2008

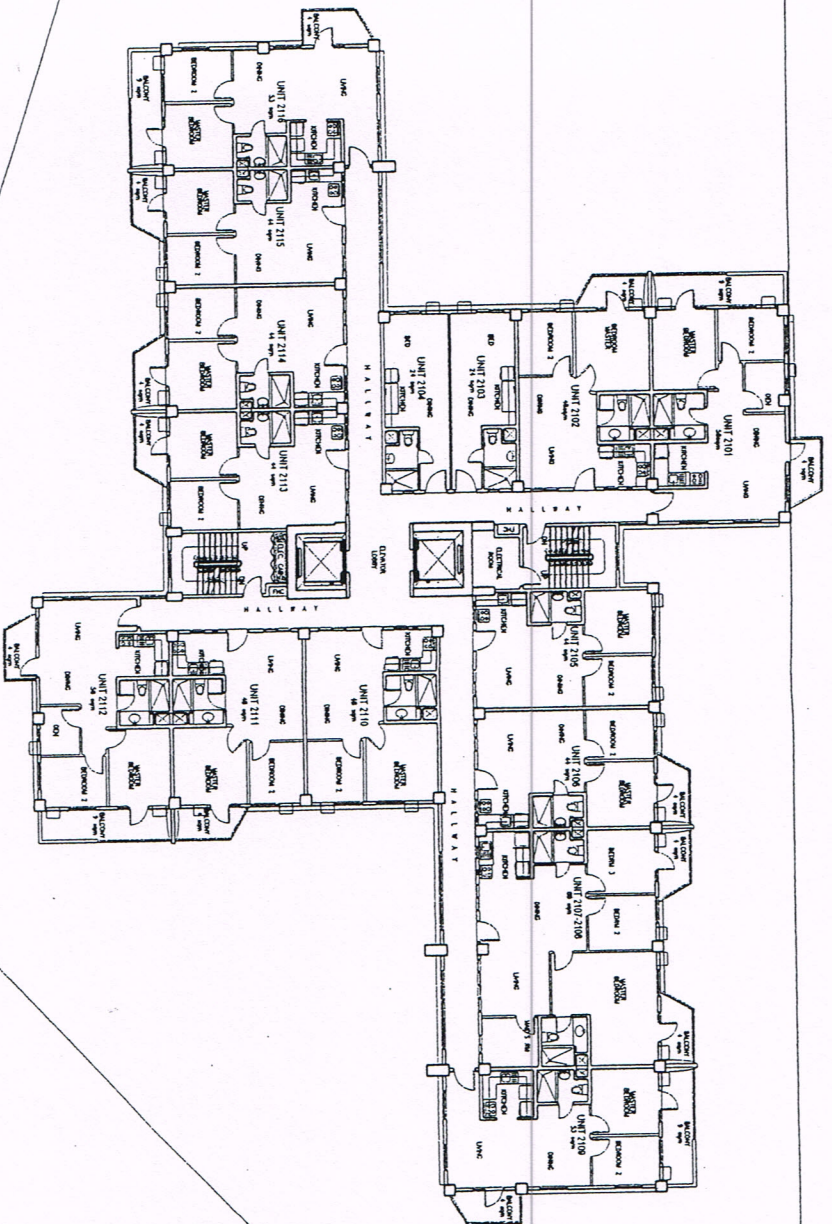



NOTED BY:	
RMS	<i>Sabin Turner</i>
AAF	<i>ALL</i>
GSA	<i>gr</i>
EGC	<i>1/1</i>

NO DATE	REVISIONS:
1/1/08	ISSUED FOR SALES AVAILABILITY
2/1/08	LESS 2 RESIDENTIAL FLOORS
3/1/08	REVISED 2ND FLOOR UNIT LAYOUT
4/1/08	REVISED 3RD FLOOR UNIT LAYOUT
5/1/08	REVISED 4TH FLOOR UNIT LAYOUT
6/1/08	REVISED 5TH FLOOR UNIT LAYOUT
7/1/08	REVISED 6TH FLOOR UNIT LAYOUT
8/1/08	REVISED 7TH FLOOR UNIT LAYOUT
9/1/08	REVISED 8TH FLOOR UNIT LAYOUT
10/1/08	REVISED 9TH FLOOR UNIT LAYOUT
11/1/08	REVISED 10TH FLOOR UNIT LAYOUT
12/1/08	REVISED 11TH FLOOR UNIT LAYOUT
1/1/09	REVISED 12TH FLOOR UNIT LAYOUT
2/1/09	REVISED 13TH FLOOR UNIT LAYOUT
3/1/09	REVISED 14TH FLOOR UNIT LAYOUT
4/1/09	REVISED 15TH FLOOR UNIT LAYOUT
5/1/09	REVISED 16TH FLOOR UNIT LAYOUT
6/1/09	REVISED 17TH FLOOR UNIT LAYOUT
7/1/09	REVISED 18TH FLOOR UNIT LAYOUT
8/1/09	REVISED 19TH FLOOR UNIT LAYOUT
9/1/09	REVISED 20TH FLOOR UNIT LAYOUT
10/1/09	REVISED 21ST FLOOR UNIT LAYOUT
11/1/09	REVISED 22ND FLOOR UNIT LAYOUT
12/1/09	REVISED 23RD FLOOR UNIT LAYOUT
1/1/10	REVISED 24TH FLOOR UNIT LAYOUT
2/1/10	REVISED 25TH FLOOR UNIT LAYOUT
3/1/10	REVISED 26TH FLOOR UNIT LAYOUT
4/1/10	REVISED 27TH FLOOR UNIT LAYOUT
5/1/10	REVISED 28TH FLOOR UNIT LAYOUT
6/1/10	REVISED 29TH FLOOR UNIT LAYOUT
7/1/10	REVISED 30TH FLOOR UNIT LAYOUT
8/1/10	REVISED 31ST FLOOR UNIT LAYOUT
9/1/10	REVISED 32ND FLOOR UNIT LAYOUT
10/1/10	REVISED 33RD FLOOR UNIT LAYOUT
11/1/10	REVISED 34TH FLOOR UNIT LAYOUT
12/1/10	REVISED 35TH FLOOR UNIT LAYOUT
1/1/11	REVISED 36TH FLOOR UNIT LAYOUT
2/1/11	REVISED 37TH FLOOR UNIT LAYOUT
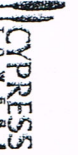

CYPRESS TOWERS
 "TOWER C" (CELESTA)
 TYPICAL 21ST - 22ND FLOOR PLAN
 02 JANUARY 2008

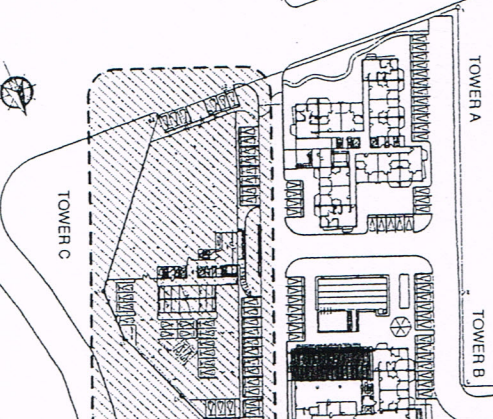

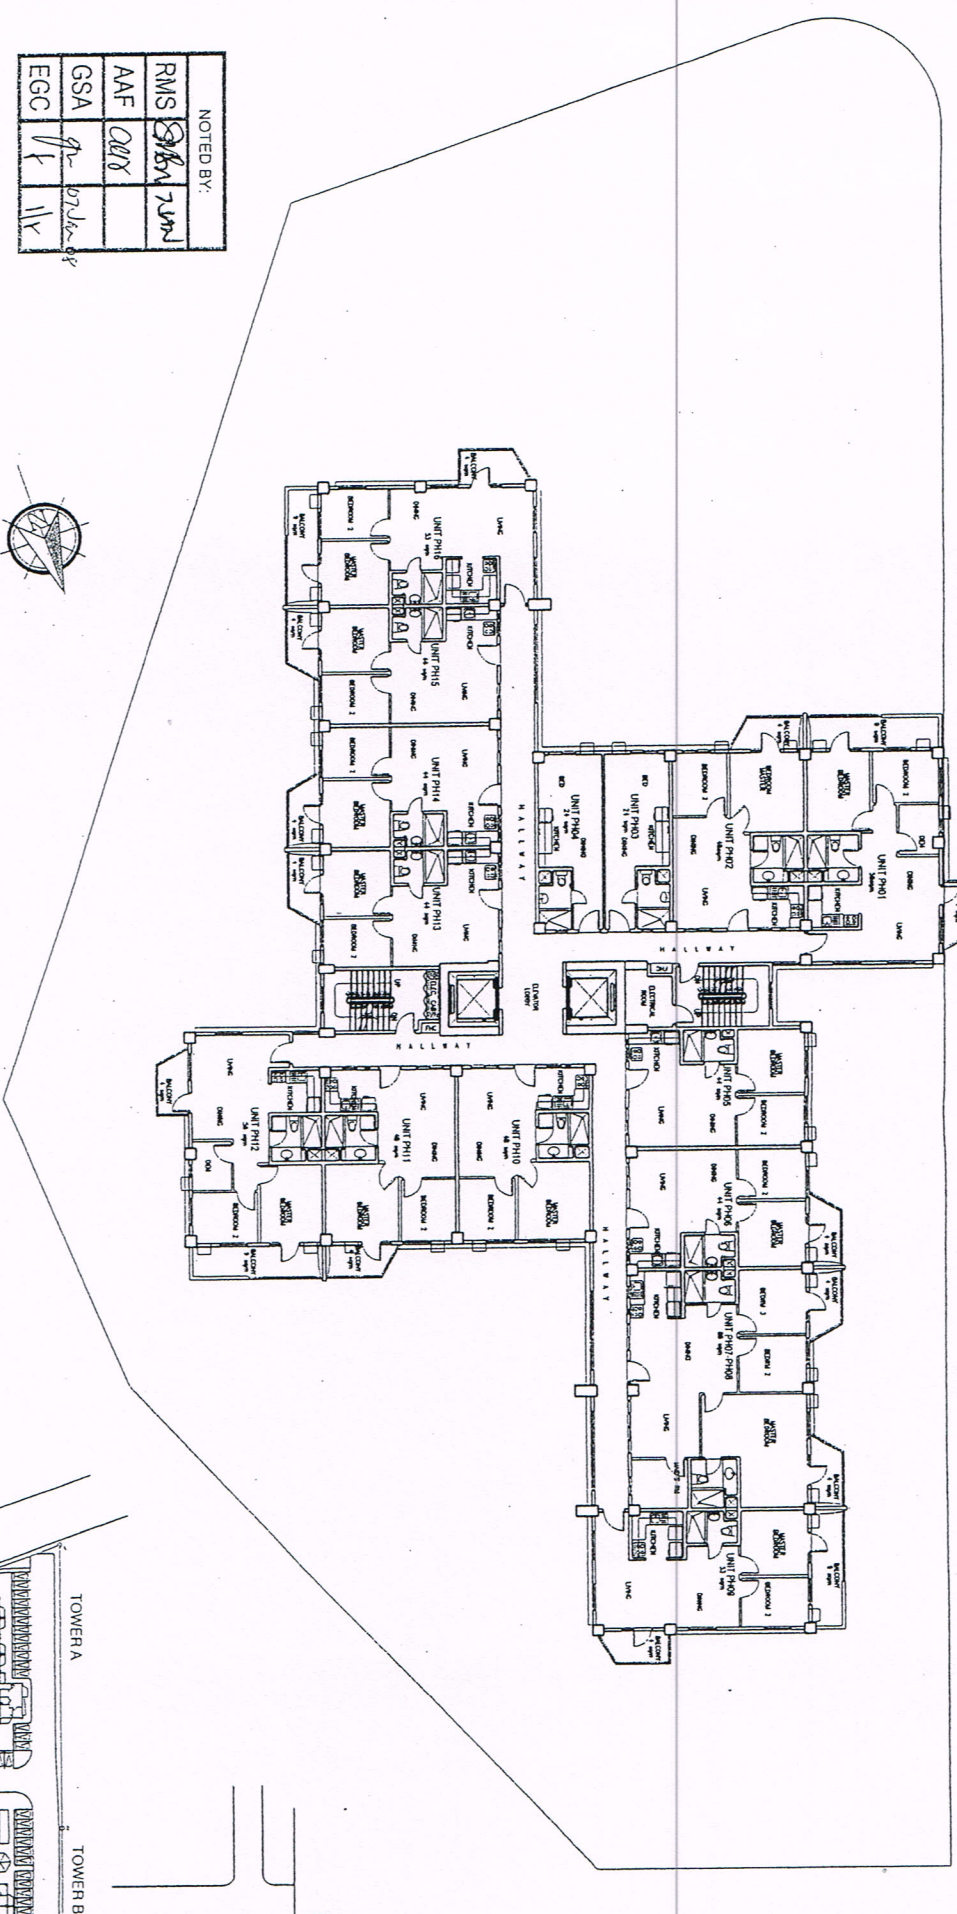


NOTED BY:

RMS	Shawn	Turn
AAF	Cliff	
GSA	for	07/16/08
EGC	11	11

NO DATE REVISIONS:

1	1/1/08	ISSUE FOR BIDDING
2	1/1/08	ISSUE FOR BIDDING
3	1/1/08	ISSUE FOR BIDDING
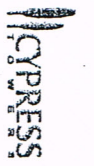

CYPRESS TOWERS
 "TOWER C" (CELESTA)
 PENTHOUSE FLOOR PLAN

02 JANUARY 2008

